IREDELL COUNTY HEALTH DEPARTMENT

STATESVILLE 704-878-5305 MOORESVILLE 704-664-5281

IMPROVEMENT PERMIT / AUTHORIZATION TO CONSTRUCT / OPERATION PERMIT / EXISTING SYSTEM INSPECTION

PERMIT # 16548820 PIN # 4659929528 DATE 3-25-2011

OWNER or APPLICANT Danny Griffin / David Crate PHONE: Business Home:

OWNER or APPLICANT ADDRESS 11609 Parks Lafferty Rd. Concord NC 28025

LOCATION / DIRECTIONS Hwy 21/115 N TR Shinnville TL Brookglen Dr Cross Creek bear rt. on left

SUBDIVISION Brookglen BLOCK / SECTION 2 LOT # 110 LOT AREA .59Ac DESIGN FLOW 360 L.T.A.R. .25-.3

Septic Tank 1000 Gallons: STB Date

Pump Tank 1000 Gallons: PT Date

Pump Make Model Serial #

Nitrification Field No Fields 1 No Lines 4 Linear Feet 360'

Trench Width 36" Max. Trench Bottom Depth 36" Gravel Depth N/A ☐ GRAVITY ☒ PRESSURE

☐ New System ☒ Repair ☐ Expansion System Type I II (III) IV V VI

System Description: Existing - 25% Reduction

Repair System Description: pump up 50% Reduction

Maintenance Agreement Required ☐ YES ☒ NO


☒ Residence No. Bedrooms 3 ☐ Business No. Persons ☐ Other No. Employees ☐ Slab ☐ Crawl Space ☐ Basement w/plumbing ☐ Basement w/o plumbing

Water Supply: ☒ Private ☐ Public ☐ Community

Comments / Conditions: Existing Septic System "appears" to be functioning okay at time of inspection

Comments / Conditions: Must keep pool "cut" 15Ft From Existing Drainfield & repair area. * May need to adjust Out Bldg so Footers are 5Ft From Drainfield & does not cover Drain Field

INITIAL SITE SKETCH

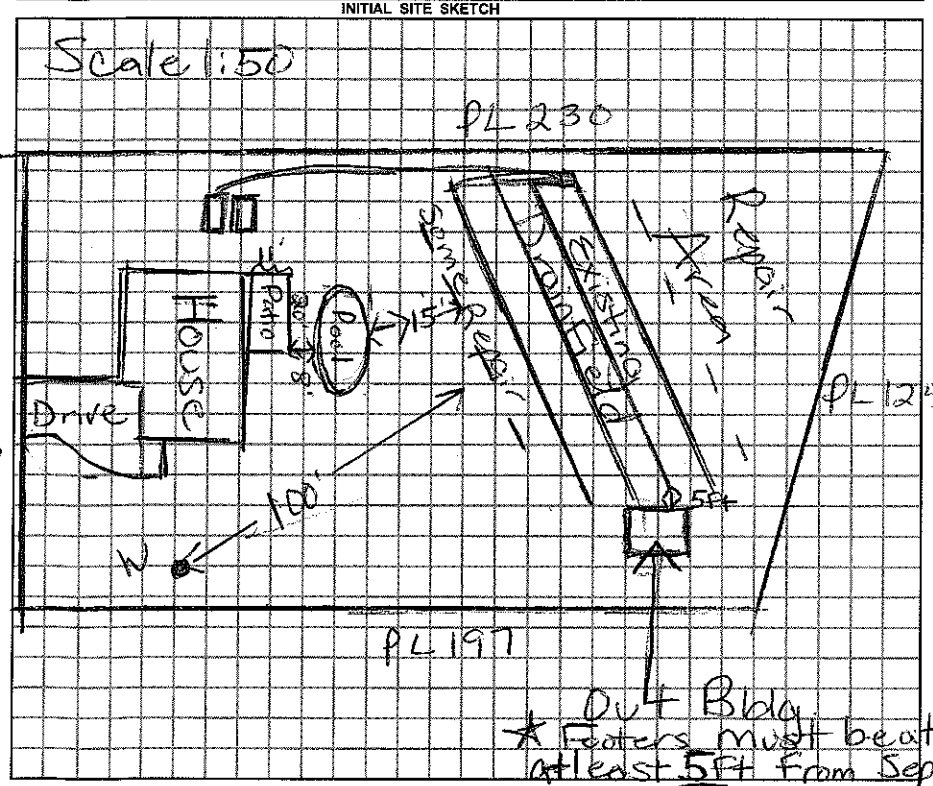

AS BUILT SKETCH

(Proposed Pool 12'x27')

Drain Field

Out Bldg.
* Footers must be at least 5Ft from Septic & Can not cover Septic System.

Permit can be suspended or revoked if any false information is supplied toward securing the permit / any unauthorized changes are made to the site / any unauthorized changes are made in the installation of the system.

☐ *IMPROVEMENT PERMIT w / plat valid without expiration.* ☐ *IMPROVEMENT PERMIT w / site plan valid for 60 mos.* ☐ *AUTHORIZATION TO CONSTRUCT valid for period equal to IMPROVEMENT PERMIT-not to exceed 60 mo.*

Owner / Applicant Signature: Danny Griffin Date 4-5-2011 Installed by: Willie Christenbury

Improvement Permit by: Date

Authorization to Construct by: Date

Operation Permit by: Date:

Existing System Inspected by: Marie H. Cotton RS Date: 3/25/2011

YOU SHOULD CONTACT A LOCATOR SERVICE PRIOR TO ANY EXCAVATION.

WHITE COPY Environmental Health YELLOW COPY (Final) Owner / Applicant PINK COPY (Initial) Owner / Applicant