IREDELL COUNTY HEALTH DEPARTMENT

STATESVILLE 704-878-5305 MOORESVILLE 704-664-5281

IMPROVEMENT PERMIT / AUTHORIZATION TO CONSTRUCT / OPERATION PERMIT / EXISTING SYSTEM INSPECTION

PERMIT# 104486 PIN# 4659-92-5352.79 4659-93-2061 DATE July 16, 02

OWNER OR CONTRACTOR KFS Investments // ES Johnson Bldrs. PHONE: Business Home

ADDRESS 149 Yacht Cove Ln. Mooresville 28117

LOCATION 115-21 N TR Statesville Rd. TL BrookGlen Dr. on left 327 Brookglen Dr.

SUBDIVISION BrookGlen BLOCK / SECTION 2 LOT 79 LOT AREA 2.36Ac SITE CLASS. PS DESIGN FLOW 360gpd L.T.A.R. N.25

Septic Tank: 1000 Gallons; STB 1012 Date 12-24-02
Pump Tank: 1000 Gallons; PT 17 Date 5-13-03
Pump Make: Goulds Model WS5511HH Serial No.
Nitrification Field: No Fields 1 Square Feet 1080 Linear Feet 360
No Lines 3@120' Trench Width 36" Max Trench Bottom Depth 36" Gravel Depth NA

☑ New System ☐ Repair System Type: I, II, III, IV, V, VI
System Description: PM - 25% Reduction
Repair System Description: LP 25-50% Reduction
Maintenance Agreement Required: ☐ Yes ☑ No

☑ House/Mod. Home No. Bedrooms 3
☐ Mobile Home No. Bathrooms 2
☐ Business No. Employees
☐ Other
☐ Slab ☑ Crawl Space ☐ Basement w/plumbing ☐ Basement wo/plumbing


Water Supply: ☑ Individual ☐ Public ☐ Community

Comments:/Conditions:

Remove any old berms terraces in septic system area.

Comments:/Conditions:

1"=100' INITIAL SITE SKETCH

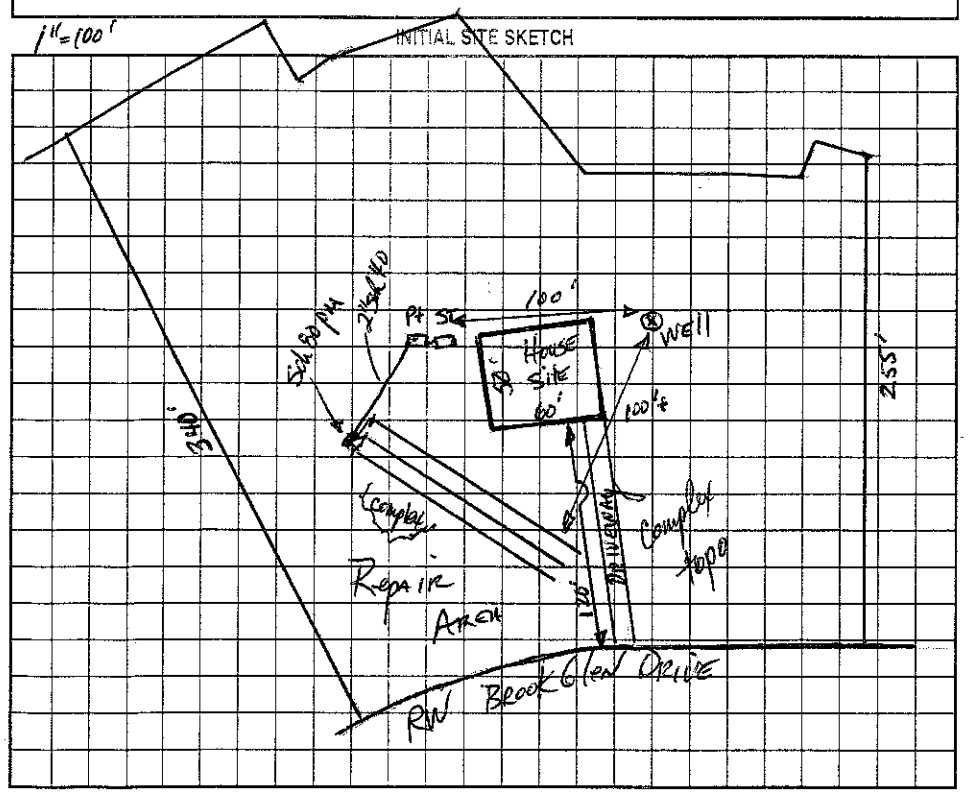

AS BUILT SKETCH

Permit can be suspended or revoked if any false information is supplied toward securing the permit/any unauthorized changes are made to the site/any unauthorized changes are made in the installation of the system. Improvement Permit with plat valid without expiration. Improvement Permit with site plan valid for sixty months. Authorization to Construct is valid for a period equal to that of Improvement Permit – not to exceed sixty months.

Signed: date 8-9-02 Installed by: Tommy Frye

Improvement Permit by: date 7-16-02 Operation Permit by: Wesley Sparks RS. date 8/28/03

Authorization to Construct by: date 2-28-03 Existing System Inspection by: date

HEALTH DEPT. COPY: WHITE OWNER COPY (FINAL): YELLOW OWNER COPY (INITIAL): PINK