IREDELL COUNTY HEALTH DEPARTMENT

Authorization to Construct

465998 0910

TATESVILLE 704-878-5305 MOORESVILLE 704-664-5281

IMPROVEMENT PERMIT / ~~CERTIFICATE OF COMPLETION~~ / OPERATION PERMIT / EXISTING SYSTEM INSPECTION

PROPERTY DESCRIPTION NO. 22660 DATE 4/9/96 TAX MAP NO. 4G 1 A 11 Watershed: ☐ Yes ☒ No

OWNER OR CONTRACTOR Michael Burke PHONE: Business _____ Home 663-4307

ADDRESS PO Box 1738 Mooresville, NC. 28115

LOCATION 115 N TR Shepard Rd. X bridge, on (R) just before top of hill

SUBDIVISION Eshenill BLOCK / SECTION _____ LOT 11 LOT AREA 4.5 Ac SITE CLASS. PS DESIGN FLOW 360 L.T.A.R. .3

Septic Tank: 1000 Gallons; STB 794 Date 12/18/95

Pump Tank: _____ Gallons; PT _____ Date _____

Pump Make: _____ Model _____ Serial No. _____

Nitrification Field: No Fields 1 Square Feet 1200 Linear Feet 400

No Lines 4 Trench Width 36" Max Trench Bottom Depth 32" Gravel Depth 12"

☒ New System ☐ Repair System Type: I (II) III IV V VI

System Description: Conventional

Repair System Description: Pressure Conventional

Maintenance Agreement Required: ☐ Yes ☐ No

☒ House/Mod. Home No. Bedrooms 3

☐ Mobile Home No. Bathrooms 2

☐ Business No. Employees _____

☐ Other _____


☐ Slab ☒ Crawl Space ☐ Basement w/plumbing ☐ Basement wo/plumbing

Water Supply: ☒ Individual ☐ Community ☐ Public

Comments: Dimensions approximate - Prop too large to scale

Comments: Installed as shown on Auth Const.

INITIAL SITE SKETCH

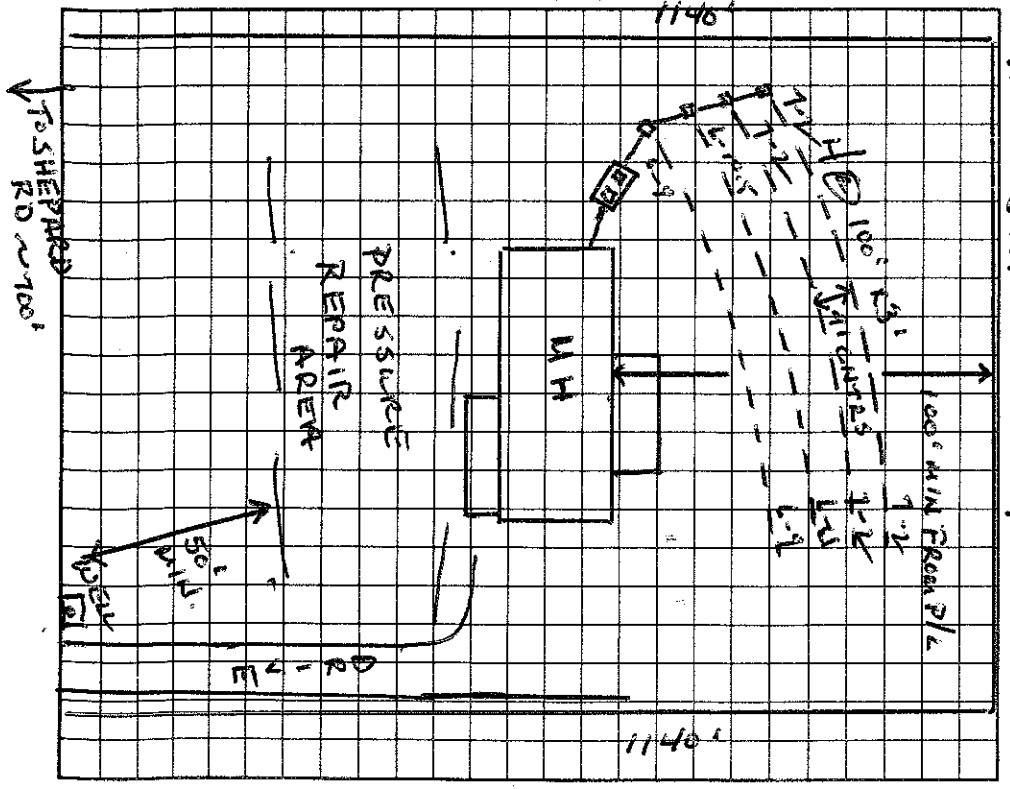

NOT TO SCALE

AS BUILT SKETCH

I understand that this permit can be suspended or revoked if any false information is supplied toward securing the permit/any unauthorized changes are made to the site/any unauthorized changes are made in the installation of the system.

Signed: [signature]

Installed by: Kelly Parker

Improvement Permit by: _____ date _____

Certificate of Completion by: _____ date _____

Authorization to Construct / Existing system inspection by: Wesley Sparks RS date 4/9/96

Operation Permit by: Wesley Sparks RS. date 7/16/96

HEALTH DEPT. COPY: WHITE INSPECTION COPY (FINAL): GREEN OWNER COPY (FINAL): YELLOW INSPECTION COPY (INITIAL): PINK OWNER COPY (INITIAL): GOLD