IREDELL COUNTY HEALTH DEPARTMENT

Authorization to Conduct 4659-89-9587 #131 Enterprise Lane

STATESVILLE 704-878-5305 MOORESVILLE 704-664-5281

IMPROVEMENT PERMIT / CERTIFICATE OF COMPLETION / OPERATION PERMIT / EXISTING SYSTEM INSPECTION

PROPERTY DESCRIPTION NO. 070558 DATE 11/20/97 TAX MAP NO. 4659 99 2550 Watershed: ☐ Yes ☒ No

OWNER OR CONTRACTOR Jerry D. Devenport PHONE: Business 4659993820 Home 528-0022

ADDRESS PO Box 1234 Mooresville, NC. 28115 528 Shepherd

LOCATION 115-21 N TR Shepherds Rd. X'creek TR Enterprise Ln.

SUBDIVISION _____ BLOCK / SECTION _____ LOT _____ LOT AREA _____ SITE CLASS. _____ DESIGN FLOW 240 L.T.A.R. .3

Septic Tank: 900 Gallons; STB 794 Date 6/24/98

Pump Tank: _____ Gallons; PT _____ Date _____

Pump Make: _____ Model _____ Serial No. _____

Nitrification Field: No Fields 1 Square Feet 960 Linear Feet 320

No Lines 3 Trench Width 36" Max Trench Bottom Depth 36" Gravel Depth 12"

☒ New System ☐ Repair System Type: I (II) III, IV, V, VI

System Description: GRAV - CONVENTIONAL

Repair System Description: SAME

Maintenance Agreement Required: ☐ Yes ☒ No

☒ House/Mod. Home ☐ Mobile Home ☐ Business ☐ Other

No. Bedrooms 2 No. Bathrooms 2 No. Employees _____

☐ Slab ☒ Crawl Space ☐ Basement w/plumbing ☐ Basement wo/plumbing


Water Supply: ☒ Individual ☐ Community ☐ Public

Comments:

Comments:

1" = 40'

INITIAL SITE SKETCH

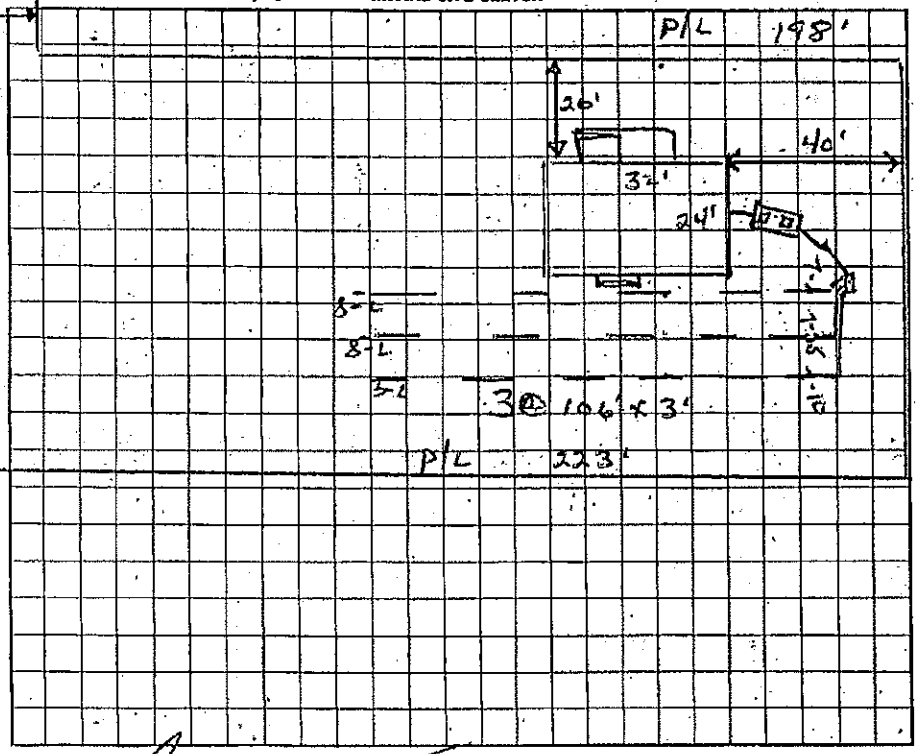

AS BUILT SKETCH

I understand that this permit can be suspended or revoked if any false information is supplied toward securing the permit/any unauthorized changes are made to the site/any unauthorized changes are made in the installation of the system. Improvement Permit is valid for 60 months from date of issuance.

Signed: Jerry Devenport

Improvement Permit by: Wesley Sparks RS. date 11/26/97

Existing System Inspection by: Wesley Sparks RS date 11/20/97

Installed by: Lesson Bintson

Certificate of Completion by: _____ date _____

Operation Permit by: Wesley Sparks RS. date 9/24/98

HEALTH DEPT. COPY: WHITE INSPECTION COPY (FINAL): GREEN OWNER COPY (FINAL): YELLOW INSPECTION COPY (INITIAL): PINK OWNER COPY (INITIAL): GOLD