IREDELL COUNTY HEALTH DEPARTMENT

STATESVILLE 704-878-5305 ~~4659 99 9587~~ MOORESVILLE 704-664-5281 4659 99 3268

IMPROVEMENT PERMIT / CERTIFICATE OF COMPLETION / OPERATION PERMIT / EXISTING SYSTEM INSPECTION

PROPERTY DESCRIPTION NO. 19025 DATE 6/14/94 TAX MAP NO. 4G-1-A-6 Watershed: ☑ Yes ☐ No

OWNER OR CONTRACTOR JERRY DAVENPORT PHONE: Business 528-0022 Home

ADDRESS RT 1 Box 435C TROUTMAN, NC. 28166

LOCATION Shepard Rd. (R) off 115-21N ~1.9 miles FROM gravel to roof field beyond barn

SUBDIVISION No BLOCK / SECTION LOT LOT AREA ~34AC SITE CLASS. P DESIGN FLOW 480 L.T.A.R. .2-.25

Septic Tank: 1000 Gallons; STB 794 Date 6/95

Pump Tank: ~~1000~~ Gallons; PT 27 Date 7/95

Pump Make: Model Serial No.

Nitrification Field: No Fields ~~Square Feet~~ Linear Feet

No Lines Trench Width Max Trench Bottom Depth Gravel Depth

☑ New System ☐ Repair System Type: I, II, (III) IV, V, VI

System Description: GRINDER PUMP TO CONV.

Repair System Description:

Maintenance Agreement Required: ☑ Yes ☐ No 5 YRS.

☑ House/Mod. Home No. Bedrooms 4

☐ Mobile Home No. Bathrooms 3

☐ Business No. Employees


☐ Other

☐ Slab ☐ Crawl Space ☑ Basement w/plumbing ☐ Basement wo/plumbing

Water Supply: ☑ Individual ☐ Community ☐ Public

Comments:
8/30/95 Changed to 2-temple pump set up. -Aws

Comments:
S/T P/T ok'd, pump set up ok'd, alarm ok'd 8/27/95 AWS

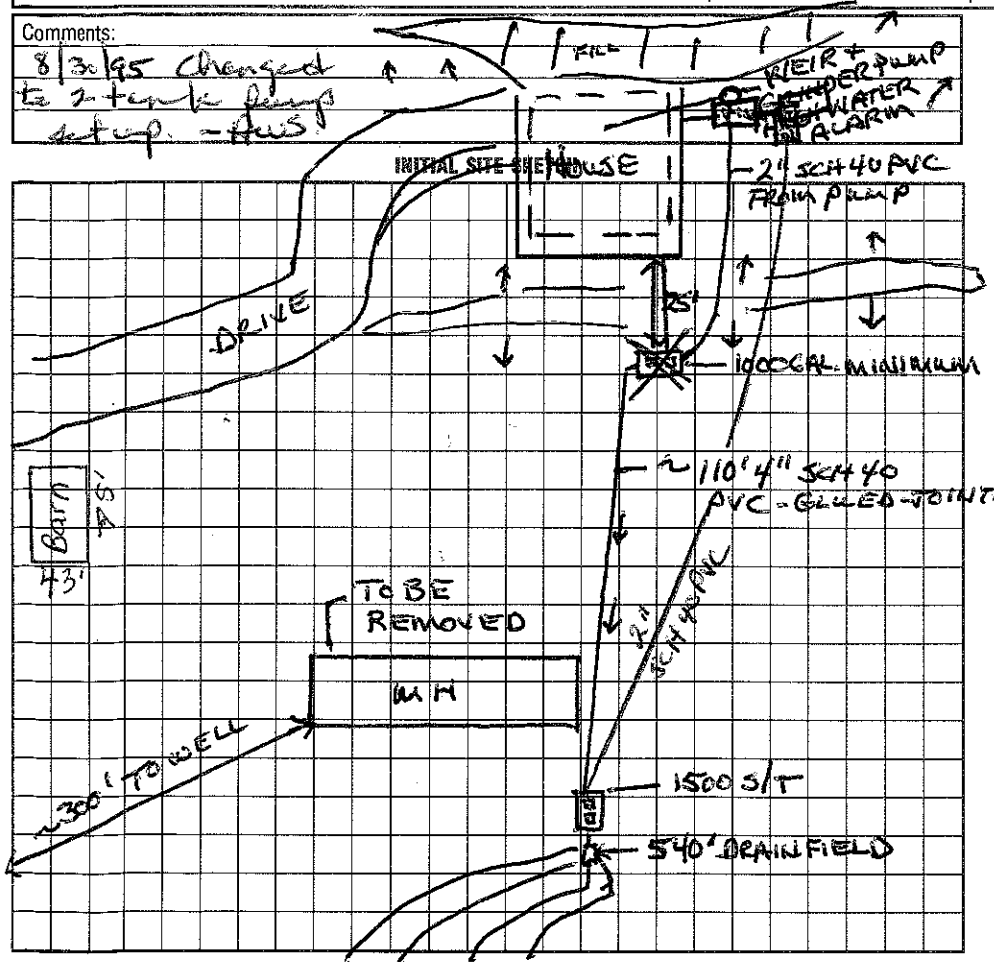

AS BUILT SKETCH

The proposed / existing Barn addition does not appear to impact the existing septic system.

**NOTE: Not to scale on site sketch

Wesley Melville R.S.

Date: 01-13-12

ICHD-Environmental Health Division

I understand that this permit can be suspended or revoked if any false information is supplied toward securing the permit/any unauthorized changes are made to the site/any unauthorized changes are made in the installation of the system. Improvement Permit is valid for 60 months from date of issuance.

Signed:

Installed by: Jerry Davenport

Improvement Permit by: Wesley Sparks R.S. date 6/14/94

Certificate of Completion by: Wesley Sparks R.S. date 10/17/95

Existing System Inspection by: Robert Conn Wesley Sparks R.S. date 10/17/95

Operation Permit by: Wesley Sparks R.S. date 10/17/95

HEALTH DEPT. COPY: WHITE INSPECTION COPY (FINAL): GREEN OWNER COPY (FINAL): YELLOW INSPECTION COPY (INITIAL): PINK OWNER COPY (INITIAL): GOLD