IREDELL COUNTY HEALTH DEPARTMENT

Authorization to Construct

STATESVILLE 704-878-5305 MOORESVILLE 704-664-5281

IMPROVEMENT PERMIT / CERTIFICATE OF COMPLETION / OPERATION PERMIT / EXISTING SYSTEM INSPECTION

PROPERTY DESCRIPTION NO. 23192 DATE 4/2/96 TAX MAP NO. 46-1-A-7 Watershed: ☐ Yes ☒ No

OWNER OR CONTRACTOR Jerry Davenport PHONE: Business _____ Home 528-9006

ADDRESS 526 Shepherds Rd. Troutman, NC. 28166

LOCATION 115-21 N TR Shepherds Rd x Bridge TR 1st grave on RT, lot on LT before gate on LT

SUBDIVISION No BLOCK / SECTION _____ LOT _____ LOT AREA _____ SITE CLASS PS DESIGN FLOW 360 L.T.A.R. .3

Septic Tank: 1000 Gallons; STB 794 Date 7/12/96

Pump Tank: _____ Gallons; PT _____ Date _____

Pump Make: _____ Model _____ Serial No. _____

Nitrification Field: No Fields 1 Square Feet 1200 Linear Feet 400

No Lines 3 Trench Width 36" Max Trench Bottom Depth 36" Gravel Depth 12"

☒ New System ☐ Repair System Type: I, II, III, IV, V, VI

System Description: GRAY - CONVENTIONAL

Repair System Description: SAME

Maintenance Agreement Required: ☐ Yes ☐ No

☐ House/Mod. Home ☒ Mobile Home ☐ Business ☐ Other

No. Bedrooms 3 No. Bathrooms 2 No. Employees ____


☐ Slab ☒ Crawl Space ☐ Basement w/plumbing ☐ Basement wo/plumbing

Water Supply: ☒ Individual ☐ Community ☐ Public

Comments: 3BR

Comments:

INITIAL SITE SKETCH

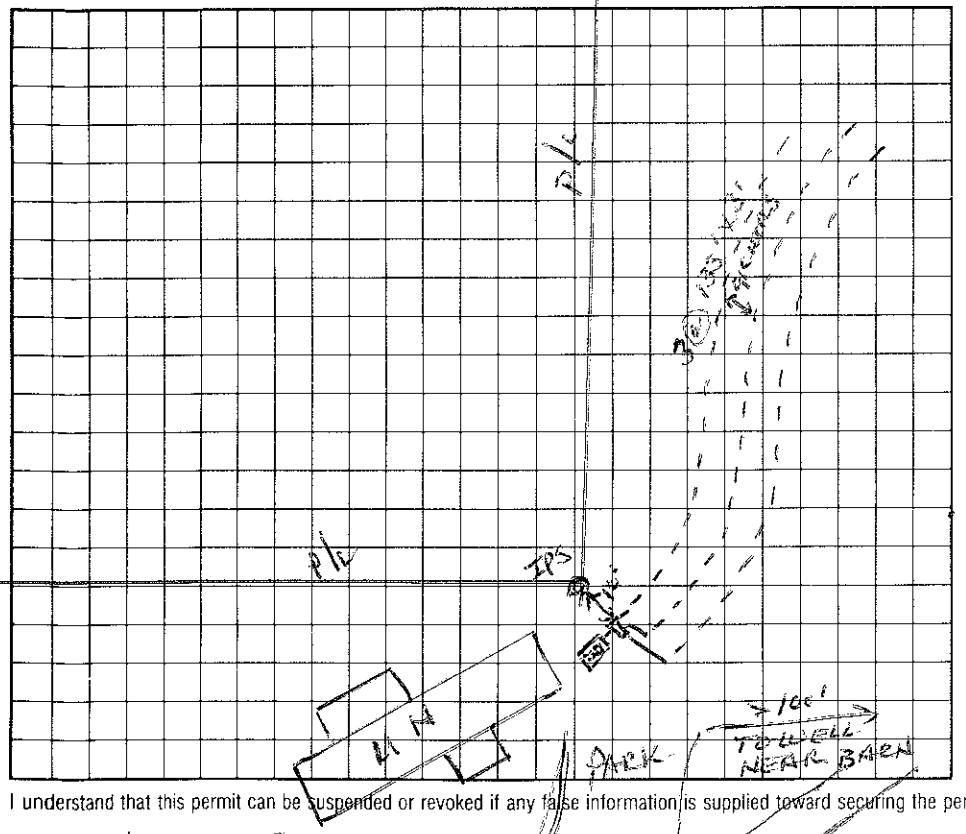

AS BUILT SKETCH

4659-89-9587

&

PARTIALLY ON

4659-99-3268

I understand that this permit can be suspended or revoked if any false information is supplied toward securing the permit/any unauthorized changes are made to the site/any unauthorized changes are made in the installation of the system.

Signed: X Janice Davenport

Improvement Permit by: _____ date _____

Existing System Inspection by: Authorization to Construct Wesley Sparkman date 4/2/96

Installed by: Jerry Davenport

Certificate of Completion by: Wesley Sparkman date 4/22/97

Operation Permit by: Wesley Sparkman date 4/22/97

HEALTH DEPT. COPY: WHITE INSPECTION COPY (FINAL): GREEN OWNER COPY (FINAL): YELLOW INSPECTION COPY (INITIAL): PINK OWNER COPY (INITIAL): GOLD