4664-18-3357 2:30

IREDELL COUNTY HEALTH DEPARTMENT

STATESVILLE 704-878-5305 MOORESVILLE 704-664-5281

IMPROVEMENT PERMIT / AUTHORIZATION TO CONSTRUCT / OPERATION PERMIT / EXISTING SYSTEM INSPECTION

PERMIT# Repair PIN# DATE 3-26-02

OWNER OR CONTRACTOR ~~Alex~~ Beam PHONE: Business 892-9853 Home

ADDRESS

LOCATION Hwy 115 S. TL Presbyterian Rd ~ 1½ mile on right - Bryant Laminate

SUBDIVISION BLOCK / SECTION LOT LOT AREA SITE CLASS. P3 DESIGN FLOW 375gpd T.A.R. .3

Septic Tank: 1000 Gallons; STB Shaw Date 1-26-02
Pump Tank: Gallons; PT Date
Pump Make: Model Serial No.
Nitrification Field: No Fields 1 Square Feet 630 Linear Feet 210
No Lines 3 @ 70' Trench Width 36" Max Trench Bottom Depth 36" Gravel Depth 12" ☒ Slab ☒ Crawl Space ☐ Basement w/plumbing ☐ Basement wo/plumbing


☒ New System ☐ Repair System Type: I. II. III. IV. V. VI.
System Description: Gravity - Conventional
Repair System Description:
Maintenance Agreement Required: ☐ Yes ☐ No

☐ House/Mod. Home No. Bedrooms
☐ Mobile Home No. Bathrooms
☒ Business No. Employees 7-8
☐ Other

Water Supply: ☒ Individual ☐ Public ☐ Community

Comments:/Conditions: Existing Septic System can be used for lower building.

INITIAL SITE SKETCH

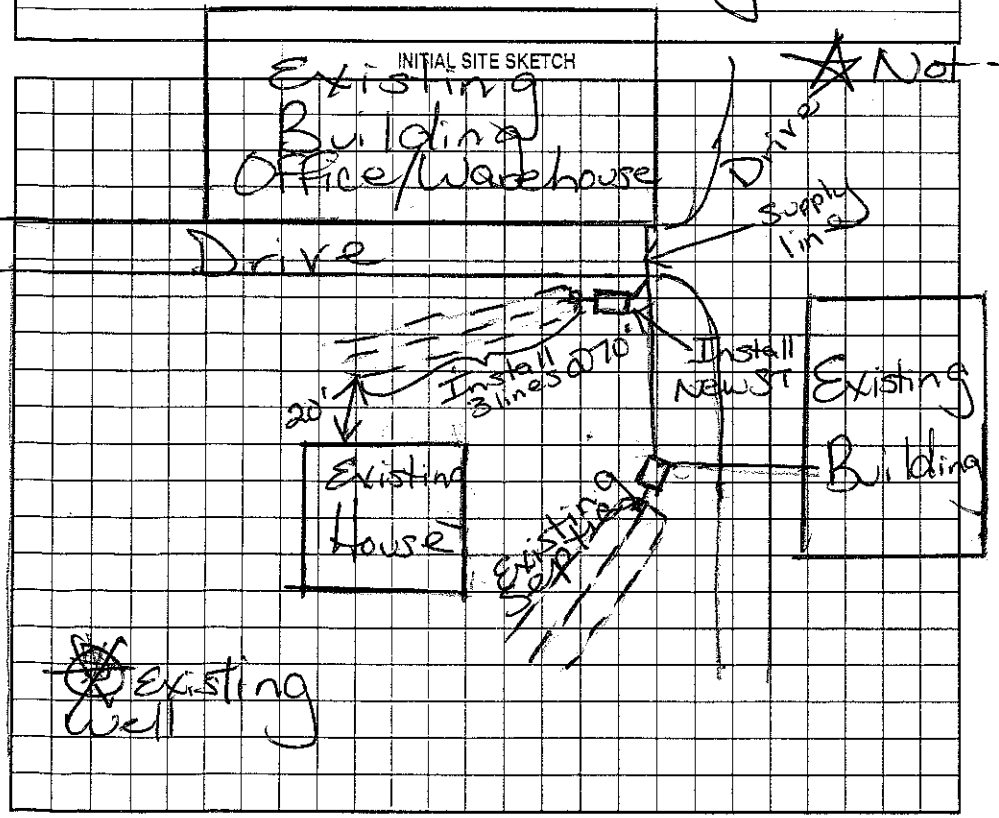

Comments:/Conditions: Install new Septic tank & Drainfield for Upper building. Office/Warehouse Risers & Filter installed.

AS BUILT SKETCH

Repair needs to be done within 30 days!

Installed as Drawn Conv. Drainfield

Permit can be suspended or revoked if any false information is supplied toward securing the permit/any unauthorized changes are made to the site/any unauthorized changes are made in the installation of the system. Improvement Permit with plat valid without expiration. Improvement Permit with site plan valid for sixty months. Authorization to Construct is valid for a period equal to that of Improvement Permit – not to exceed sixty months.

Signed: ~~Ben~~ date Installed by: Bennie Myers

Improvement Permit by: Maria H. Dobson RS date 3/26/02 Operation Permit by: Maria H. Dobson RS date 4/29/02

Authorization to Construct by: Maria H. Dobson RS date 3/26/02 Existing System Inspection by: date

HEALTH DEPT. COPY: WHITE OWNER COPY (FINAL): YELLOW OWNER COPY (INITIAL): PINK