IREDELL COUNTY HEALTH DEPARTMENT

STATESVILLE 704-878-5305 MOORESVILLE 704-664-5281

IMPROVEMENT PERMIT / AUTHORIZATION TO CONSTRUCT / OPERATION PERMIT / EXISTING SYSTEM INSPECTION

PERMIT # _____ PIN # 4664249694 DATE 7-30-2012

OWNER or APPLICANT Martha Strawn PHONE: Business _____ Home: 704 892-5130

OWNER or APPLICANT ADDRESS P.O. Box 936 Davidson, NC 28036 (Front on Property in Meek Co.)

LOCATION / DIRECTIONS Shearers Rd (S) TR Greystone past Abersham subdivision to 1st drive on right (address out front 3301 Magnolia tree on left of drive

SUBDIVISION _____ BLOCK / SECT _____ LOT # _____ LOT AREA 9ac. DESIGN FLOW 480 L.T.A.R. .3

Existing

Septic Tank 1000 Gallons: STB _____ Date _____

Pump Tank _____ Gallons: P T _____ Date _____

Pump Make _____ Model _____ Serial # _____

Nitrification Field No Fields 1 No Lines 4 Linear Feet 200

Trench Width 36" Max. Trench Bottom Depth 30" Gravel Depth N/A

☐ New System ☐ Repair ☒ Expansion System Type I II (III) IV V VI

System Description Gravity – 25% Reduction

Repair System Description Modified Conventional

Maintenance Agreement Required ☐ YES ☒ NO

☐ GRAVITY ☐ PRESSURE

☒ Residence No. Bedrooms 4

☐ Business No. Persons _____

☐ Other No. Employees _____

☐ Slab ☒ Crawl Space

☐ Basement w/plumbing ☐ Basement w/o plumbing

Water Supply: ☒ Private ☐ Public ☐ Community

Upgrade to Existing System

Comments / Conditions


Lean Shed

Pool House

Comments / Conditions Hook onto end of existing drainfield (bore Supply line 30" under drive or sleeve in ductile iron) Install 4 lines @ 50ft ea to upgrade to 4 Bedrooms Note: 2 lines @ 50ft ea (100ft Total) for 3 Bedroom

INITIAL SITE SKETCH

Scale 1:60

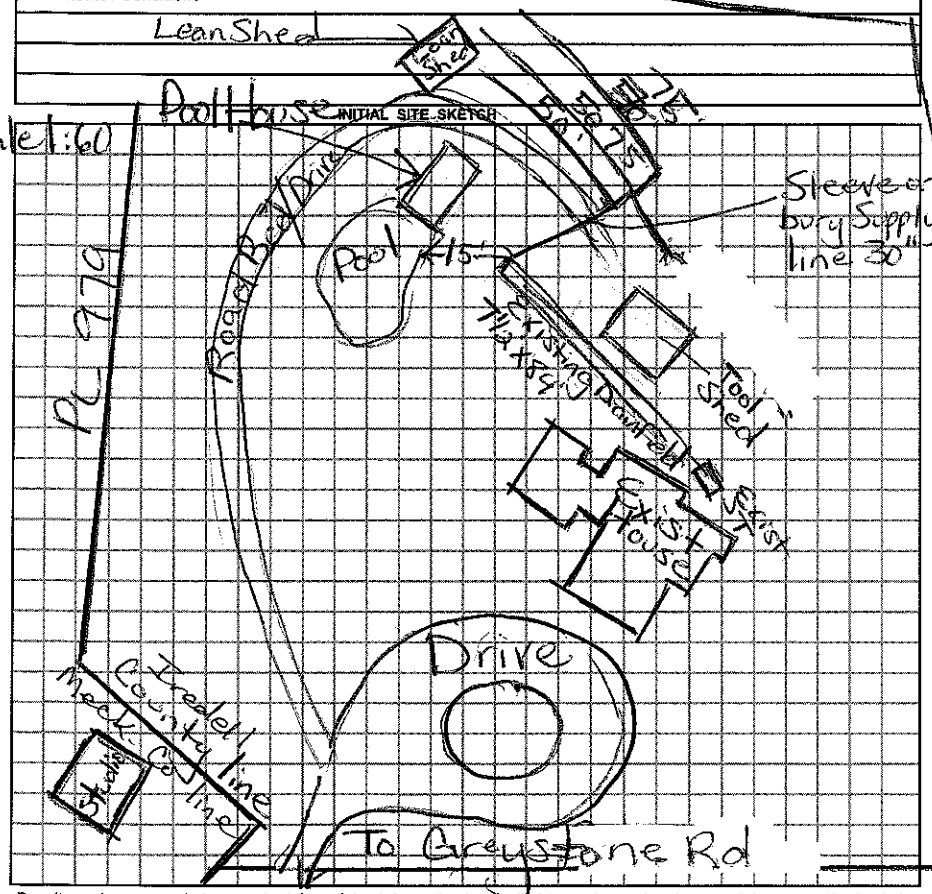

AS BUILT SKETCH

Must Keep Septic System at least 5ft from any Building Consult with Iredell Co HD prior to installation.

Installed Quick 4

1-50, 2-75 lines

Serial Dist.

(Connected onto end of existing System)

Permit can be suspended or revoked if any false information is supplied toward securing the permit / any unauthorized changes are made to the site / any unauthorized changes are made in the installation of the system.

☐ IMPROVEMENT PERMIT w / plat valid without expiration ☐ IMPROVEMENT PERMIT w / site plan valid for 60 mos. ☐ AUTHORIZATION TO CONSTRUCT valid for period equal to IMPROVEMENT PERMIT-not to exceed 60 mo.

Owner / Applicant Signature: Martha Strawn Date 7/31/12

Improvement Permit by: Maine H. Dolan RS Date 7/30/12

Authorization to Construct by: Maine H. Dolan RS Date 7/30/12

Installed by: E.J. Erwin RS

Operation Permit by: Maine H. Dolan Date: 11/13/12

Existing System Inspected by: _____ Date: _____

YOU SHOULD CONTACT A LOCATOR SERVICE PRIOR TO ANY EXCAVATION.

WHITE COPY Environmental Health YELLOW COPY (Final) Owner / Applicant PINK COPY (Initial) Owner / Applicant