IREDELL COUNTY HEALTH DEPARTMENT

STATESVILLE 704-878-5305 MOORESVILLE 704-664-5281

IMPROVEMENT PERMIT / AUTHORIZATION TO CONSTRUCT / OPERATION PERMIT / EXISTING SYSTEM INSPECTION

PERMIT# 073525 PIN# ~~4664-28-6932 (PT)~~ ~~4664-88-5325~~ 4664284352 DATE 7/21/98

OWNER OR CONTRACTOR Luis Cruz PHONE: Business 662-9807 Home

ADDRESS 361 W Playa Dr. Mooresville NC. 28115

LOCATION 1155 TL Presbyterian Rd. TR Davidson Ridge on (R) at cul de sac

SUBDIVISION Davidson Ridge BLOCK / SECTION LOT 8 LOT AREA .85 Ac SITE CLASS. PS DESIGN FLOW 480 L.T.A.R. .3

Septic Tank: 1000 Gallons; STB 794 Date 9/4/99
Pump Tank: Gallons; PT Date
Pump Make: Model Serial No.
Nitrification Field: No Fields 1 Square Feet 1600 Linear Feet 533
No Lines 5 Trench Width 36" Max Trench Bottom Depth 36" Gravel Depth 12"

☒ New System ☐ Repair System Type: I, II, III, IV, V, VI
System Description: Gravity Conventional
Repair System Description: Gravity PPBS
Maintenance Agreement Required: ☐ Yes ☒ No


☒ House/Mod. Home No. Bedrooms 4
☐ Mobile Home No. Bathrooms 2.5
☐ Business No. Employees
☐ Other
☐ Slab ☒ Crawl Space ☐ Basement w/plumbing ☐ Basement wo/plumbing

Water Supply: ☒ Individual ☐ Public ☐ Community


Comments:/Conditions:

Comments:/Conditions:

INITIAL SITE SKETCH

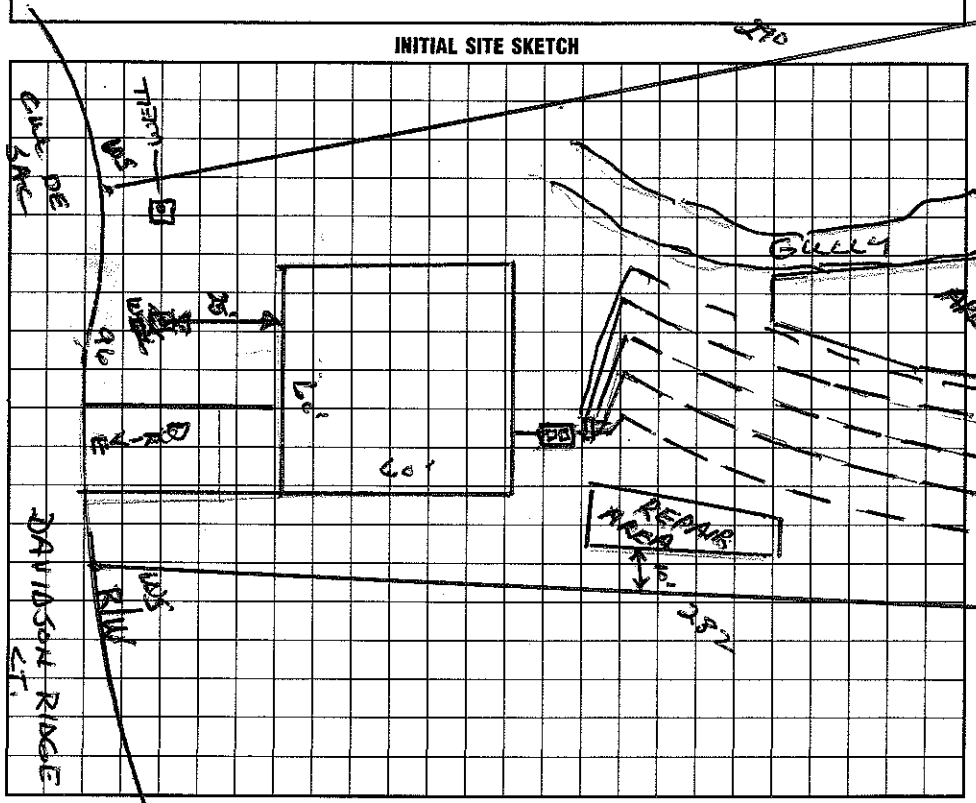

AS BUILT SKETCH

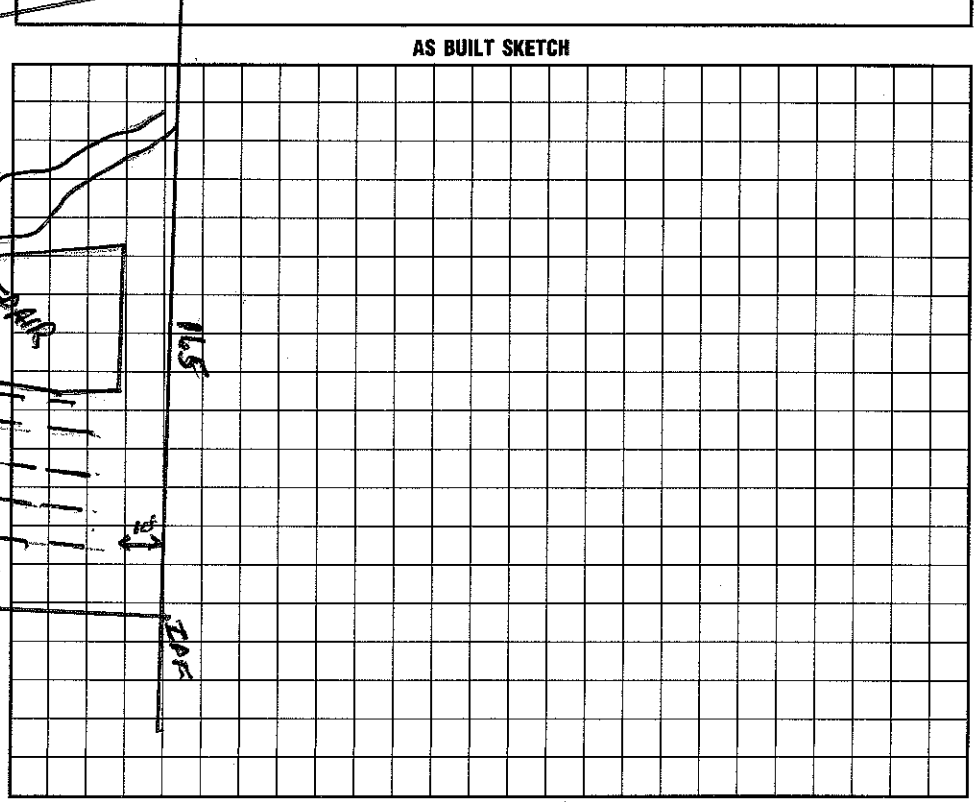

I understand that this permit can be suspended or revoked if any false information is supplied toward securing the permit/any unauthorized changes are made to the site/any unauthorized changes are made in the installation of the system. Improvement Permit with plat valid without expiration. Improvement Permit with site plan valid for sixty months. Authorization to Construct is valid for a period equal to that of Improvement Permit – not to exceed sixty months.

Signed: * date 7-23-98 Installed by: Tim Ammons.

Improvement Permit by: Wesley Sparks R.S. date 7/21/98 Operation Permit by: Wesley Sparks R.S. date 3/23/00

Authorization to Construct by: Wesley Sparks R.S. date 7/21/98 Existing System Inspection by: date

HEALTH DEPT. COPY: WHITE INSPECTION COPY (FINAL): GREEN OWNER COPY (FINAL): YELLOW INSPECTION COPY (INITIAL): PINK OWNER COPY (INITIAL): GOLD