IREDELL COUNTY HEALTH DEPARTMENT

Authorization to Construct

STATESVILLE 704-878-5305 MOORESVILLE 704-664-5281

IMPROVEMENT PERMIT / ~~CERTIFICATE OF COMPLETION~~ / OPERATION PERMIT / EXISTING SYSTEM INSPECTION

PROPERTY DESCRIPTION NO. 26275 DATE 4/3/97 TAX MAP NO. 4664 28 4713 Watershed: ☐ Yes ☒ No

OWNER OR CONTRACTOR Alan Russell PHONE: Business ______ Home 394-8110

ADDRESS 6912 Paul Tuckett Rd. Charlotte, NC 28214

LOCATION Sherrill Rd TR Presbyterian TL first drive after Dodd Hill subdivision to end of drive on R

SUBDIVISION IC All Pt of BLOCK / SECTION ______ LOT ______ LOT AREA ~4Ac SITE CLASS. PS DESIGN FLOW 360 L.T.A.R. .25

Septic Tank: 500+250 Gallons; STB 112 Date 9/27/99

Pump Tank: ______ Gallons; PT ______ Date ______

Pump Make: ______ Model ______ Serial No. ______

Nitrification Field: No Fields 1 Square Feet 1440 Linear Feet 480

No Lines 5 Trench Width 36" Max Trench Bottom Depth 30" Gravel Depth 12"

☒ New System ☐ Repair System Type: I (II) III, IV, V, VI

System Description: GRAVITY - CONVENTIONAL

Repair System Description: SAME

Maintenance Agreement Required: ☐ Yes ☒ No

☒ House/Mod. Home No. Bedrooms 3

☐ Mobile Home No. Bathrooms 2

☐ Business No. Employees ______

☒ Other Garbage Disposal


☐ Slab ☐ Crawl Space ☐ Basement w/plumbing ☑ Basement wo/plumbing

Water Supply: ☒ Individual ☐ Community ☐ Public


Comments:

Comments:

INITIAL SITE SKETCH

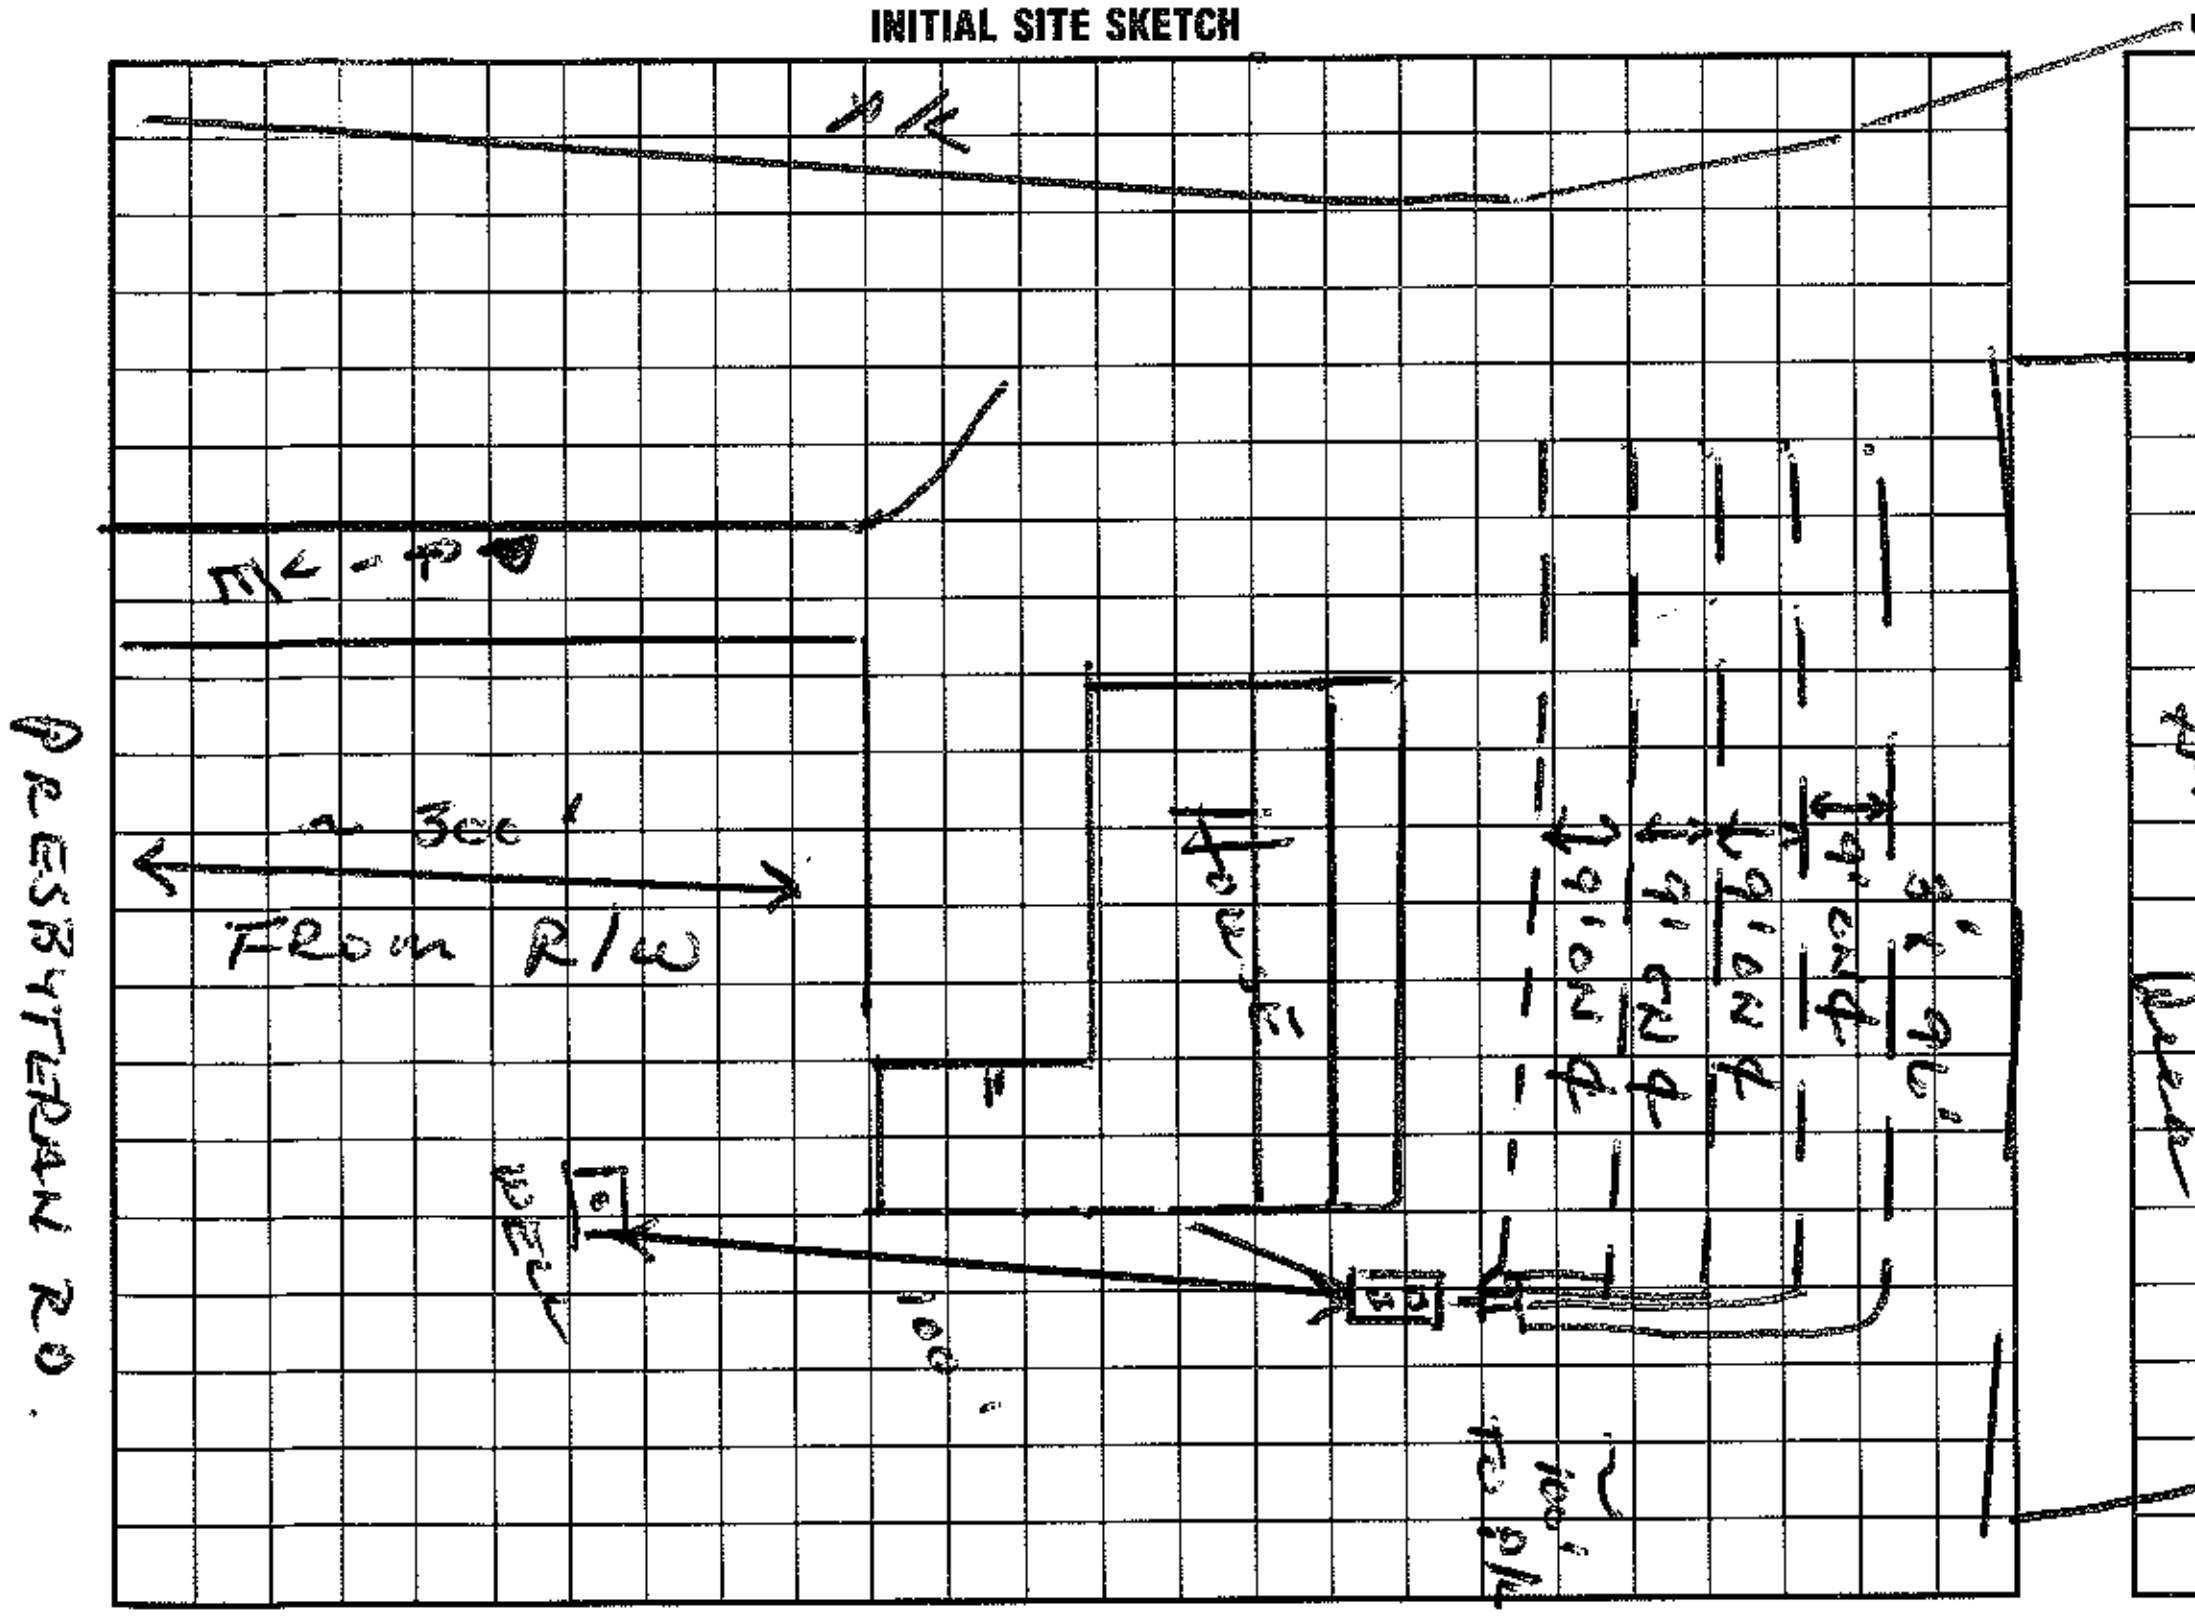

AS BUILT SKETCH

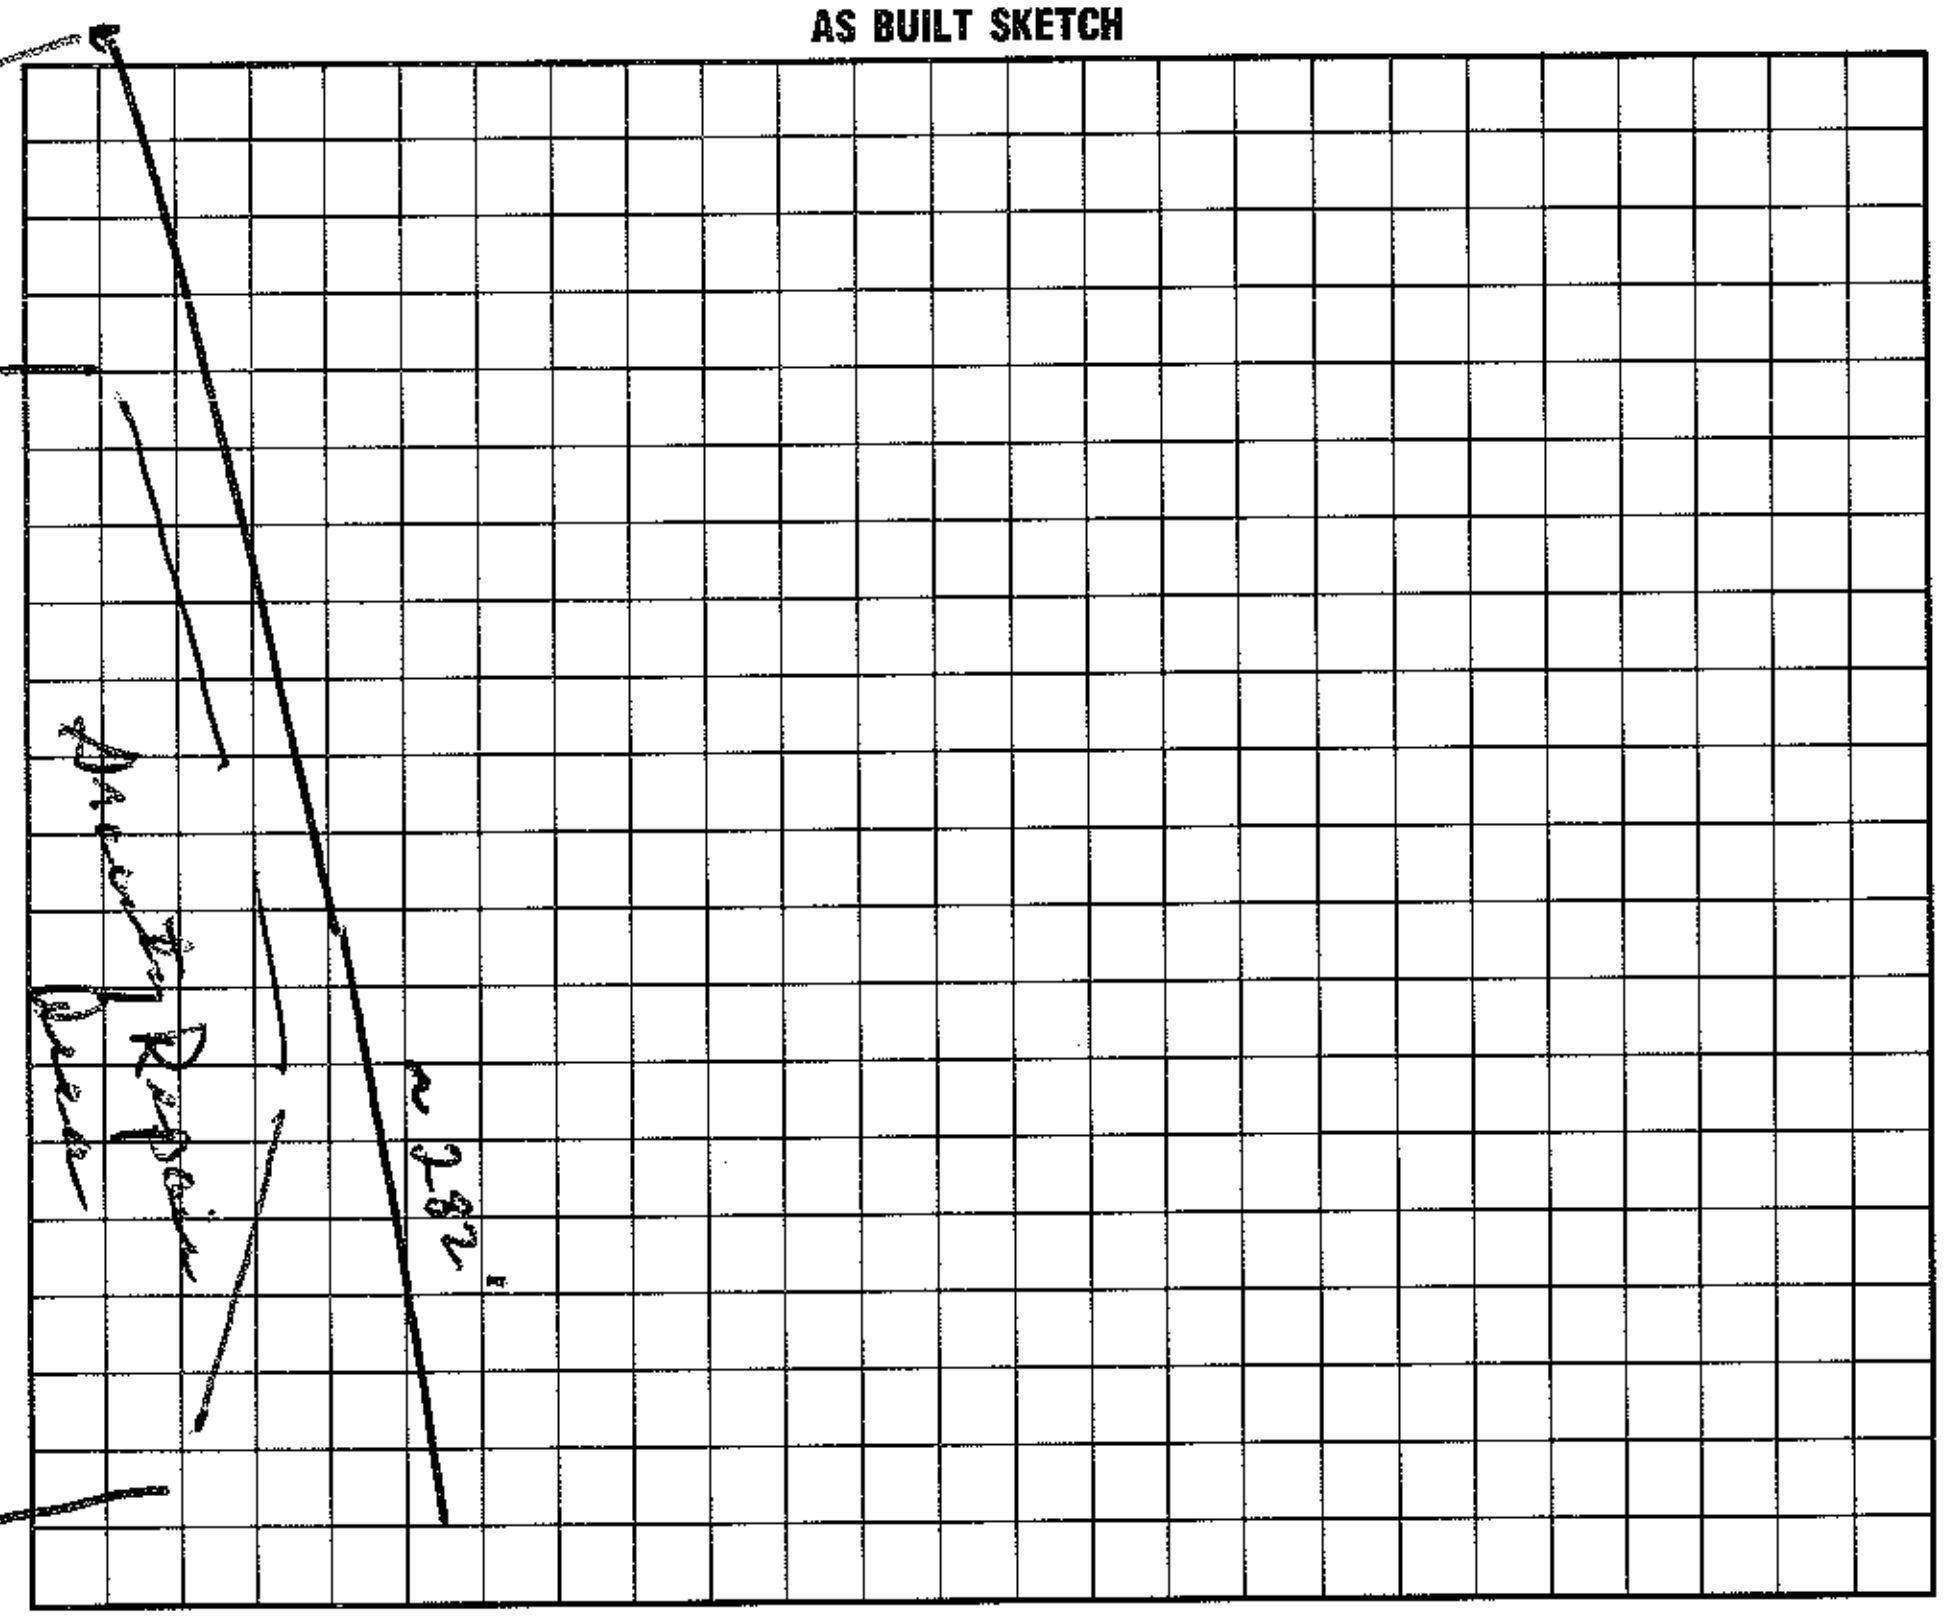

I understand that this permit can be suspended or revoked if any false information is supplied toward securing the permit/any unauthorized changes are made to the site/any unauthorized changes are made in the installation of the system. Improvement Permit is valid for 60 months from date of issuance.

Signed: X Deborah Nattery

Improvement Permit by: Wesley Sparks R.S. date 4/3/97

Existing System Inspection by: Auth. To Construct Wesley Sparks RS date 4/3/97

Installed by: HOVELL CONSTRUCTION

Certificate of Completion by: C. [signature] date ______

Operation Permit by: C. [signature] date 11/23/99

HEALTH DEPT. COPY: WHITE INSPECTION COPY (FINAL): GREEN OWNER COPY (FINAL): YELLOW INSPECTION COPY (INITIAL): PINK OWNER COPY (INITIAL): GOLD