IREDELL COUNTY HEALTH DEPARTMENT

STATESVILLE 704-878-5305 50.00 Paid MOORESVILLE 704-664-5281

IMPROVEMENT PERMIT / AUTHORIZATION TO CONSTRUCT / OPERATION PERMIT / EXISTING SYSTEM INSPECTION

PERMIT# 103072 PIN# 4664-28-7847 DATE 5/2/02

OWNER OR CONTRACTOR Mike Bodick PHONE: Business Home 704 309 6810

ADDRESS PO Box 1281 Davidson NC 28036

LOCATION Shears PR, Presbyterian, TL Davidson Ridge on corner

SUBDIVISION Davidson Ridge BLOCK / SECTION LOT 5 LOT AREA 2.11ac SITE CLASS PS DESIGN FLOW 360 L.T.A.R. 0.55

Septic Tank: 1000 Gallons; STB 1012 Date 3/7/02

Pump Tank: 1000 Gallons; PT 17 Date 12/~~23~~/01

Pump Make: Model Serial No.

Nitrification Field: No Fields 1 Square Feet 774 Linear Feet 258

No Lines 3@86' Trench Width 36" Max Trench Bottom Depth 36" Gravel Depth —

☒ New System ☐ Repair System Type: I, II, (III), IV, V, VI

System Description: Pump 25% Reduction

Repair System Description: Some

Maintenance Agreement Required: ☐ Yes ☒ No

☒ House/Mod. Home ☐ Mobile Home ☐ Business ☐ Other

No. Bedrooms 5 No. Bathrooms 2 No. Employees


Water Supply: ☒ Individual ☐ Public ☐ Community

☐ Slab ☒ Crawl Space ☐ Basement w/plumbing ☐ Basement wo/plumbing


Comments:/Conditions:

Comments:/Conditions:

INITIAL SITE SKETCH

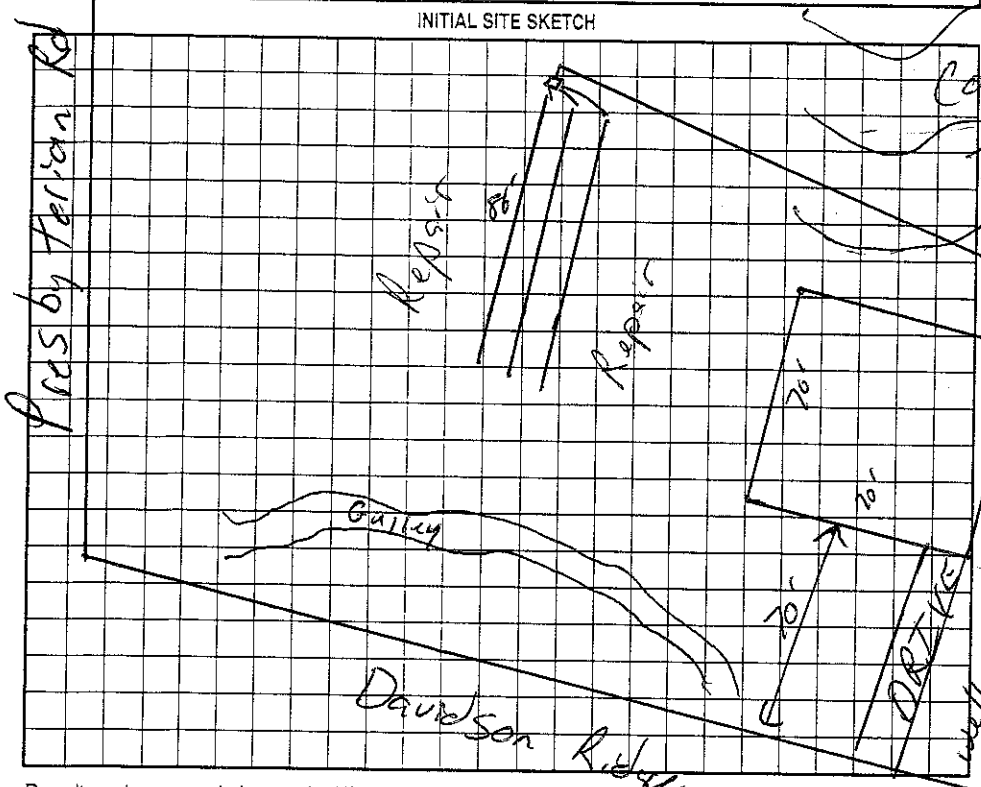

AS BUILT SKETCH

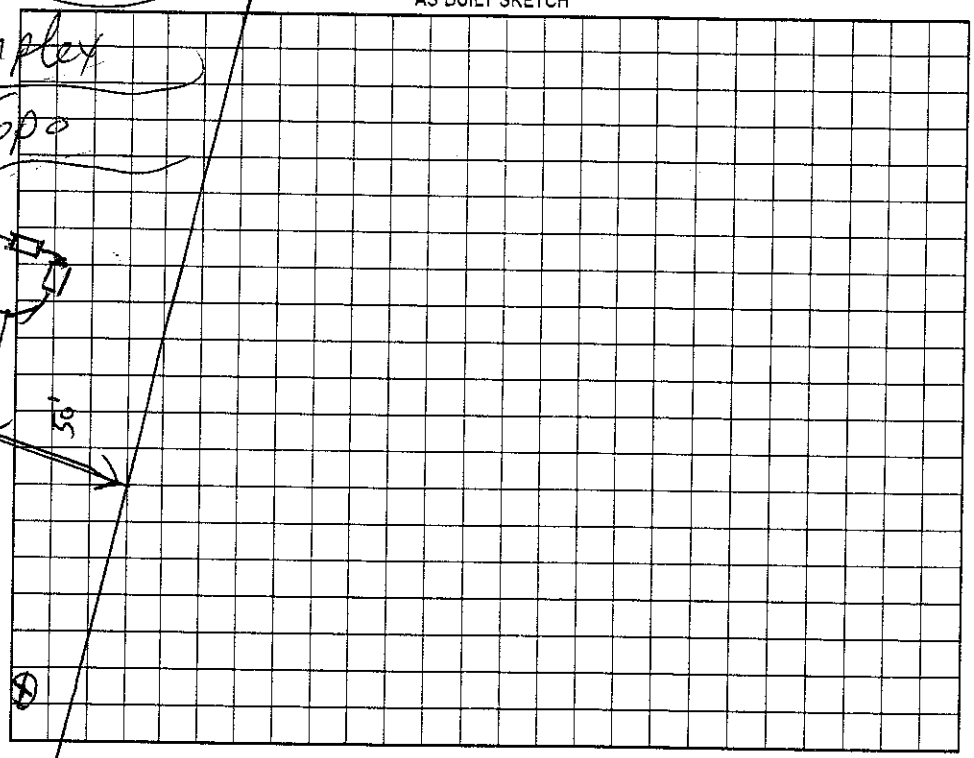

Permit can be suspended or revoked if any false information is supplied toward securing the permit/any unauthorized changes are made to the site/any unauthorized changes are made in the installation of the system. Improvement Permit with plan valid without expiration. Improvement Permit with site plan valid for sixty months. Authorization to Construct is valid for a period equal to that of Improvement Permit – not to exceed sixty months.

Signed: date 5-3-02 Installed by: Richard Abernathy

Improvement Permit by: RS date 5/2/02 Operation Permit by: RS date 6/29/02

Authorization to Construct by: RS date 5/2/02 Existing System Inspection by: date

HEALTH DEPT. COPY: WHITE OWNER COPY (FINAL): YELLOW OWNER COPY (INITIAL): PINK