IREDELL COUNTY HEALTH DEPARTMENT

STATESVILLE 704-878-5305 MOORESVILLE 704-664-5281

IMPROVEMENT PERMIT / AUTHORIZATION TO CONSTRUCT / OPERATION PERMIT / EXISTING SYSTEM INSPECTION

PERMIT# D81995 PIN# 4664287188 PT 4664289155 DATE 7/2/99

OWNER OR CONTRACTOR Ricky King PHONE: Business 363-4842 Home 664-3173

ADDRESS 412 Stutts Rd Mooresville NC 28117

LOCATION Hwy 115 South TL Presbyterian Rd go across bridge & uphill TR Davidson Ridge Incl-de sac

SUBDIVISION Davidson Ridge BLOCK / SECTION ____ LOT 13 LOT AREA .85 Acre SITE CLASS. PS DESIGN FLOW 360gpd L.T.A.R. .3 OWRt.

Septic Tank: 1000 Gallons; STB 794 Date 11/17/99
Pump Tank: 1000 Gallons; PT 29 Date 1/21/00
Pump Make: Gould Model WE0 311 Serial No. 11/99
Nitrification Field: No Fields 1 Square Feet 900' Linear Feet 300'
No Lines 6@+50' Trench Width 36" Max Trench Bottom Depth 36 Gravel Depth N/A


☐ New System ☐ Repair System Type: I, II, III, IV, V, VI
System Description: Pump-AM-25% Reduction
Repair System Description: Pump-Panel Block
Maintenance Agreement Required: ☐ Yes ☒ No

☒ House/Mod. Home No. Bedrooms 3
☐ Mobile Home No. Bathrooms 2
☐ Business No. Employees ____
☐ Other ____
☐ Slab ☒ Crawl Space ☐ Basement w/plumbing ☐ Basement wo/plumbing

Water Supply: ☒ Individual ☐ Public ☐ Community


Comments/Conditions: Keep Septic System at least 10' from PL, 5' from House, 15' from Pool & 50' from lake. Keep lines 5' from "property" Filled gully.

INITIAL SITE SKETCH

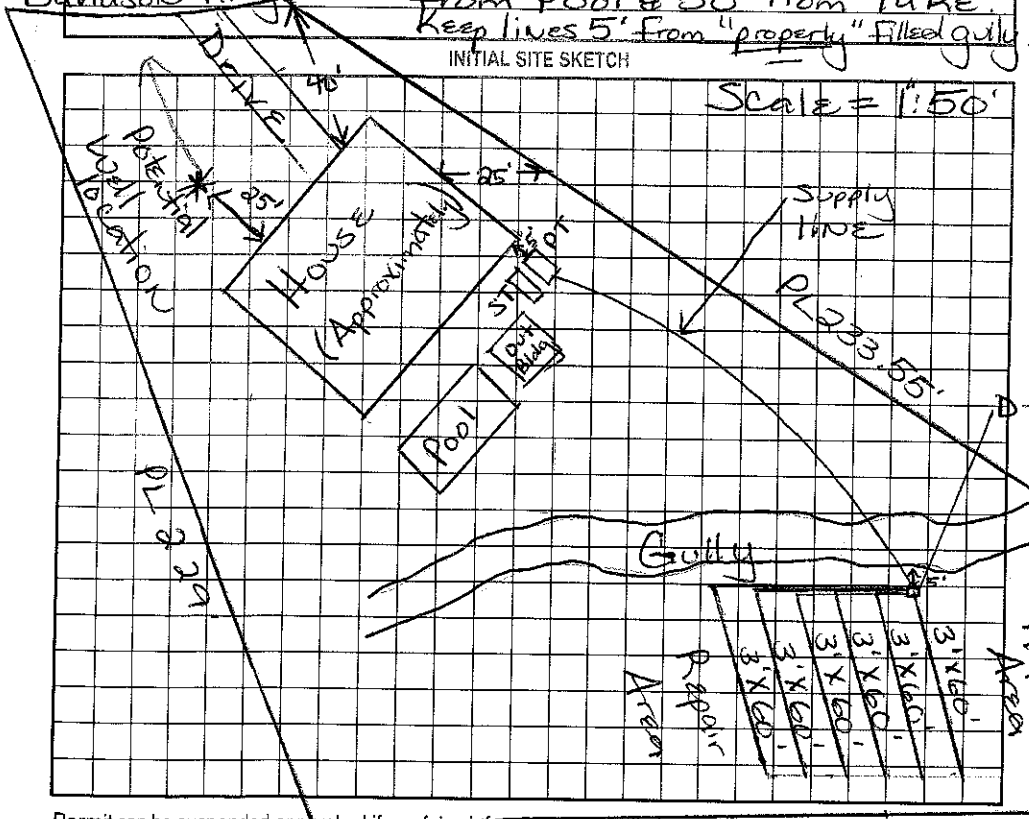

Comments/Conditions: To "properly" fill gully-remove organics other debris from gullied areas & fill w/ PS soil. Do not grade or remove soil from Septic drainfield area. Keep well 25' from House & 50' from any Septic System.

AS BUILT SKETCH

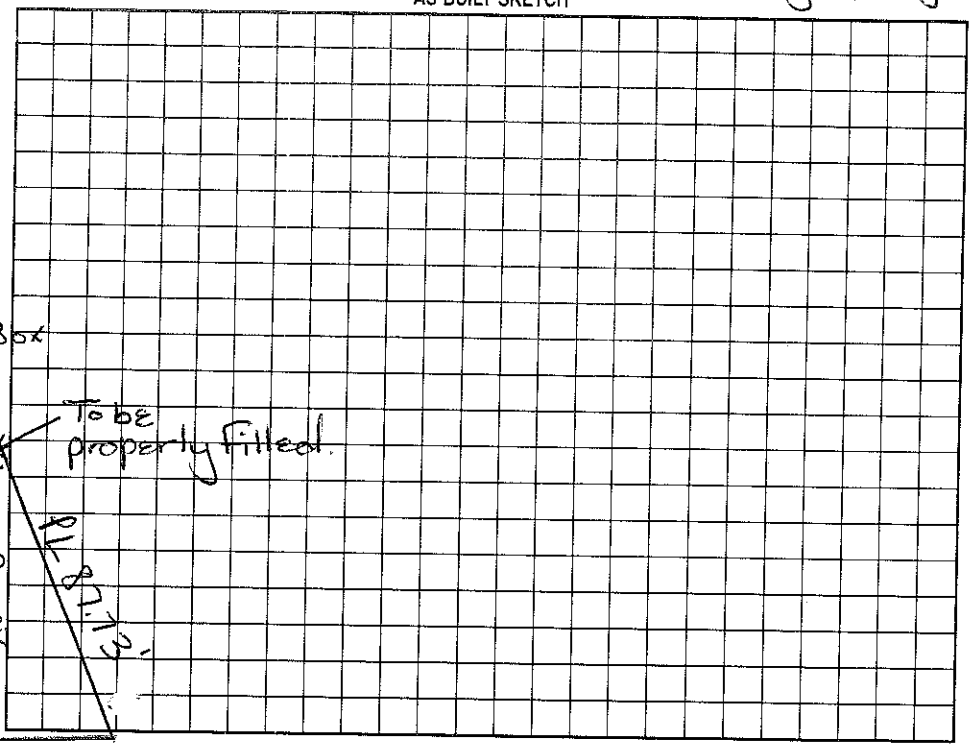

Permit can be suspended or revoked if any false information is supplied toward securing the permit/any unauthorized changes are made to the site/any unauthorized changes are made in the installation of the system. Improvement Permit with plat valid without expiration. Improvement Permit with site plan valid for sixty months. Authorization to Construct is valid for a period equal to that of Improvement Permit – not to exceed sixty months.

Signed: Ricky King date 8-3-99 Installed by: Curt Dunning

Improvement Permit by: Maria H. H. Dotson date 7/6/99 Operation Permit by: Wesley Hobbs RS. date 3/16/00

Authorization to Construct by: Maria H. H. Dotson date 7/6/99 Existing System Inspection by: ____ date ____

HEALTH DEPT. COPY: WHITE OWNER COPY (FINAL): YELLOW OWNER COPY (INITIAL): PINK