IREDELL COUNTY HEALTH DEPARTMENT

STATESVILLE 704-878-5305 MOORESVILLE 704-664-5281

IMPROVEMENT PERMIT / AUTHORIZATION TO CONSTRUCT / OPERATION PERMIT / EXISTING SYSTEM INSPECTION

PERMIT# 105811 PIN# ~~4664-28-9853~~ 4664-28-9853 DATE 12/4/03

OWNER OR CONTRACTOR David McDaniel PHONE: Business _____ Home 704-660-0726

ADDRESS 254 Bay Harbor Rd Mooresville NC 28117

LOCATION Stearers, TR Presbyterian, on Lt. before Davidson Ridge Rd.

SUBDIVISION Davidson Ridge BLOCK / SECTION _____ LOT 15 LOT AREA 2.1 Ac SITE CLASS. PS DESIGN FLOW 360 L.T.A.R. 0.3

Septic Tank: 1000 Gallons; STB 825 Date 10/11/03
Pump Tank: _____ Gallons; PT _____ Date _____
Pump Make: _____ Model _____ Serial No. _____
Nitrification Field: No Fields 1 Square Feet 900 Linear Feet 300'
No Lines 4@75' Trench Width 36" Max Trench Bottom Depth 36" Gravel Depth —

☒ New System ☐ Repair System Type: I, II, (III) IV, V, VI
System Description: Gravity 25% Reduct.
Repair System Description: Same
Maintenance Agreement Required: ☐ Yes ☒ No


☒ House/Mod. Home No. Bedrooms 3
☐ Mobile Home No. Bathrooms 2½
☐ Business No. Employees ____
☐ Other _____
☐ Slab ☒ Crawl Space ☐ Basement w/plumbing ☐ Basement wo/plumbing

Water Supply: ☒ Individual ☐ Public ☐ Community

Comments:/Conditions:

Comments:/Conditions:

INITIAL SITE SKETCH

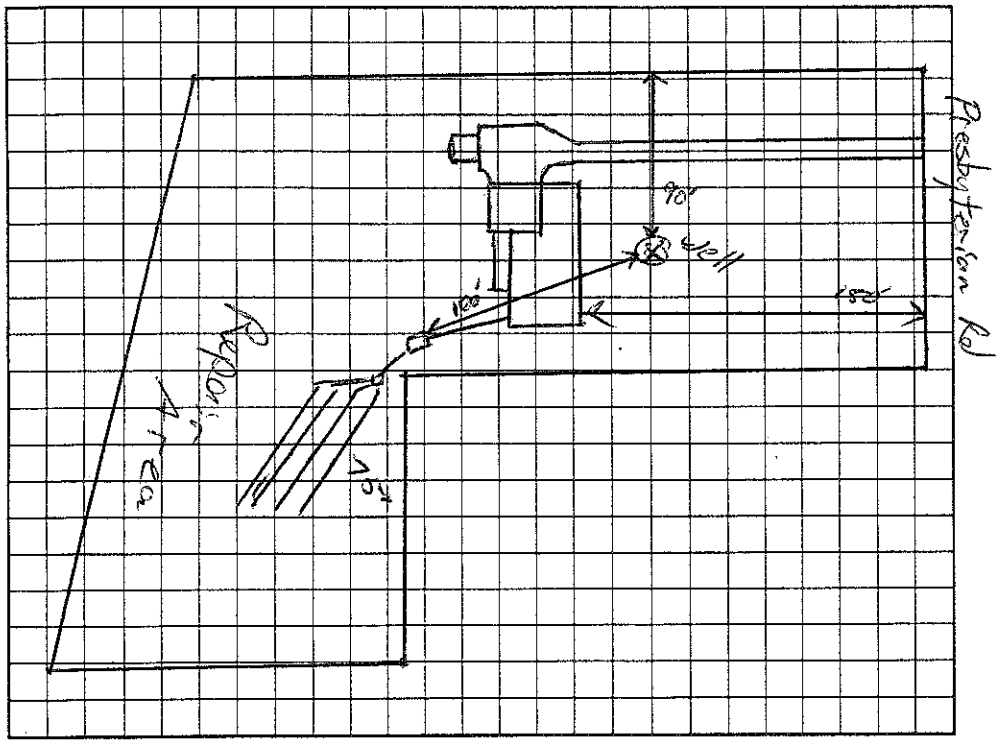

AS BUILT SKETCH

Infiltrators Installed

As Drawn

Permit can be suspended or revoked if any false information is supplied toward securing the permit/any unauthorized changes are made to the site/any unauthorized changes are made in the installation of the system. Improvement Permit with plat valid without expiration. Improvement Permit with site plan valid for sixty months. Authorization to Construct is valid for a period equal to that of Improvement Permit – not to exceed sixty months.

Signed: _____ date 12-5-03 Installed by: Rowan Septic

Improvement Permit by: _____ RS date 12/4/03 Operation Permit by: _____ RS date 12/8/03

Authorization to Construct by: _____ RS date 12/4/03 Existing System Inspection by: _____ date _____

HEALTH DEPT. COPY: WHITE OWNER COPY (FINAL): YELLOW OWNER COPY (INITIAL): PINK