IREDELL COUNTY HEALTH DEPARTMENT

Authorization to Construct 11:30

STATESVILLE 704-878-5305 MOORESVILLE 704-664-5281

IMPROVEMENT PERMIT / ~~CERTIFICATE OF COMPLETION~~ / OPERATION PERMIT / EXISTING SYSTEM INSPECTION

PROPERTY DESCRIPTION NO. 25830 DATE 1/7/97 TAX MAP NO. Watershed: ☐ Yes ☒ No

OWNER OR CONTRACTOR Wayne Parker PHONE: Business PNH 4664-29-5269 Home

ADDRESS PO Box 353 Mt Mourne, NC. 28123

LOCATION Presbyterian Rd. on (L) just past trucking company 2 1/2 miles past Rocky Creek on (L)

SUBDIVISION Gulf Trace BLOCK / SECTION LOT 3 LOT AREA 2+/- Ac SITE CLASS PS DESIGN FLOW 240 L.T.A.R. .35

Septic Tank: 1000 Gallons; STB 760 Date 10/15/96

Pump Tank: Gallons; PT Date

Pump Make: Model Serial No.

Nitrification Field: No Fields 1 Square Feet 685 Linear Feet 230

No Lines 3 Trench Width 36" Max Trench Bottom Depth 36" Gravel Depth 12"

☒ New System ☐ Repair System Type: I, II, III, IV, V, VI

System Description: CONV - GRAVITY

Repair System Description: SAME

Maintenance Agreement Required: ☐ Yes ☒ No

☐ House/Mod. Home No. Bedrooms 2

☒ Mobile Home No. Bathrooms 2

☐ Business No. Employees

☐ Other

☐ Slab ☒ Crawl Space ☐ Basement w/plumbing ☐ Basement wo/plumbing


Water Supply: ☒ Individual ☐ Community ☐ Public

FM # 1


Comments: Lines on contour in Initial sketch

Comments: LINES SAME AS CONTOUR - TANK 50' FROM TRAILER.

INITIAL SITE SKETCH

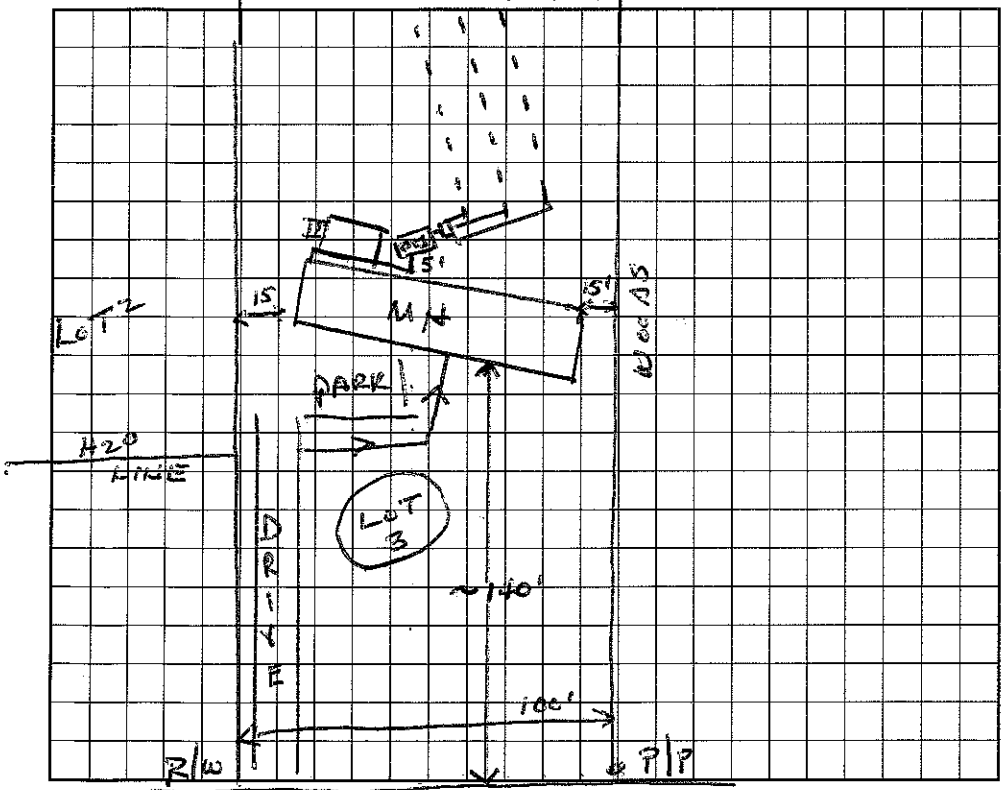

AS BUILT SKETCH

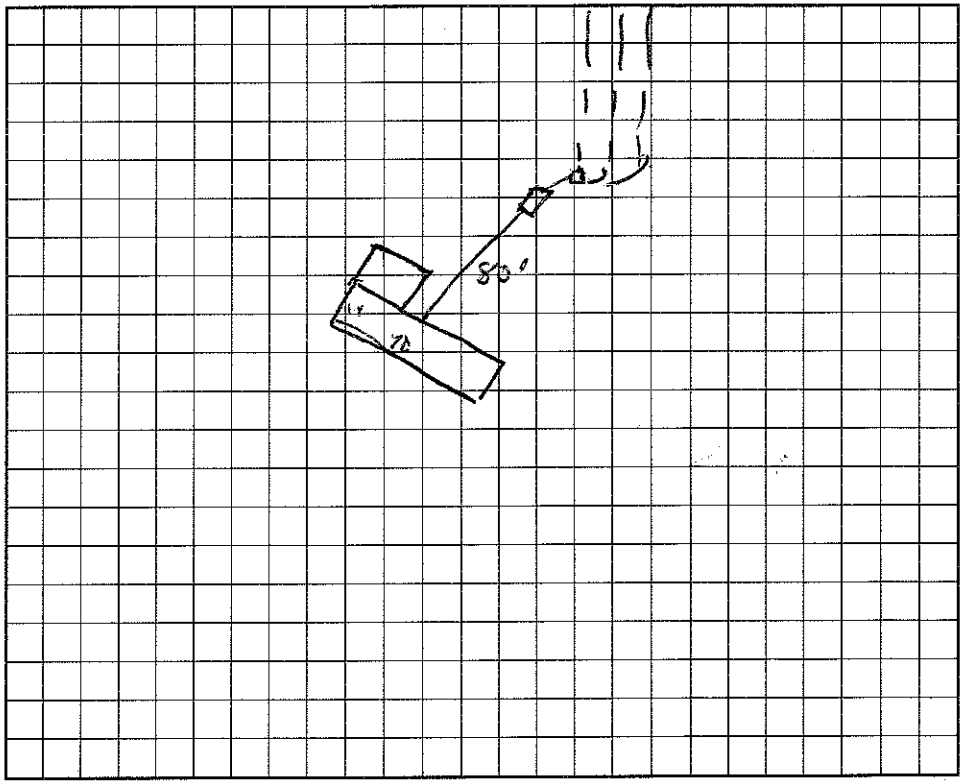

I understand that this permit can be suspended or revoked if any false information is supplied toward securing the permit/any unauthorized changes are made to the site/any unauthorized changes are made in the installation of the system.

Signed: Wayne Parker

Improvement Permit by: Wesley Sparks RS. date 1/7/97

Existing System Inspection by: Wesley Sparks RS. date 1/7/97

Installed by: GRIMES

Certificate of Completion by: date

Operation Permit by: date 1/24/97

HEALTH DEPT. COPY: WHITE INSPECTION COPY (FINAL): GREEN OWNER COPY (FINAL): YELLOW INSPECTION COPY (INITIAL): PINK OWNER COPY (INITIAL): GOLD