IREDELL COUNTY HEALTH DEPARTMENT STATE 704-878-5305 MOORESVILLE 704-664-5281

IMPROVEMENT PERMIT / AUTHORIZATION TO CONSTRUCT / OPERATION PERMIT / EXISTING SYSTEM INSPECTION

PERMIT # 157425 PIN # 4664 29 7303 DATE 9/21/09

OWNER or APPLICANT DAN + LYNN SKIDMORE PHONE: Business Home:

OWNER or APPLICANT ADDRESS 120 ROCKWELL LP MOORESVILLE, NC. 28115

LOCATION / DIRECTIONS 611 PRESBYTERIAN RD, MOORESVILLE, NC. 28115

SUBDIVISION GOLD TRACE BLOCK / SECTION LOT # 4 LOT AREA ~1.03AC DESIGN FLOW 480 L.T.A.R. .3

Septic Tank EXISTING Gallons: STB Date

Pump Tank Gallons: PT Date

Pump Make Model Serial #

Nitrification Field No Fields 1 No Lines 1 Linear Feet ~~100~~ 301

Trench Width 3 Max. Trench Bottom Depth 3' Gravel Depth 12"

☐ New System ☐ Repair ☒ Expansion System Type I (II) III IV V VI

System Description: GRAVEL OR 25% REDUCTION

Repair System Description: SAME TYPE

Maintenance Agreement Required ☐ YES ☒ NO

☐ GRAVITY ☐ PRESSURE

☒ Residence No. Bedrooms 4

☐ Business No. Persons

☐ Other No. Employees

☐ Slab ☐ Crawl Space


☐ Basement w/plumbing ☒ Basement w/o plumbing

Water Supply: ☒ Private ☐ Public ☐ Community

Comments / Conditions

Comments / Conditions INFILTRATOR INSTALLED - 25% REDUCTION

INITIAL SITE SKETCH

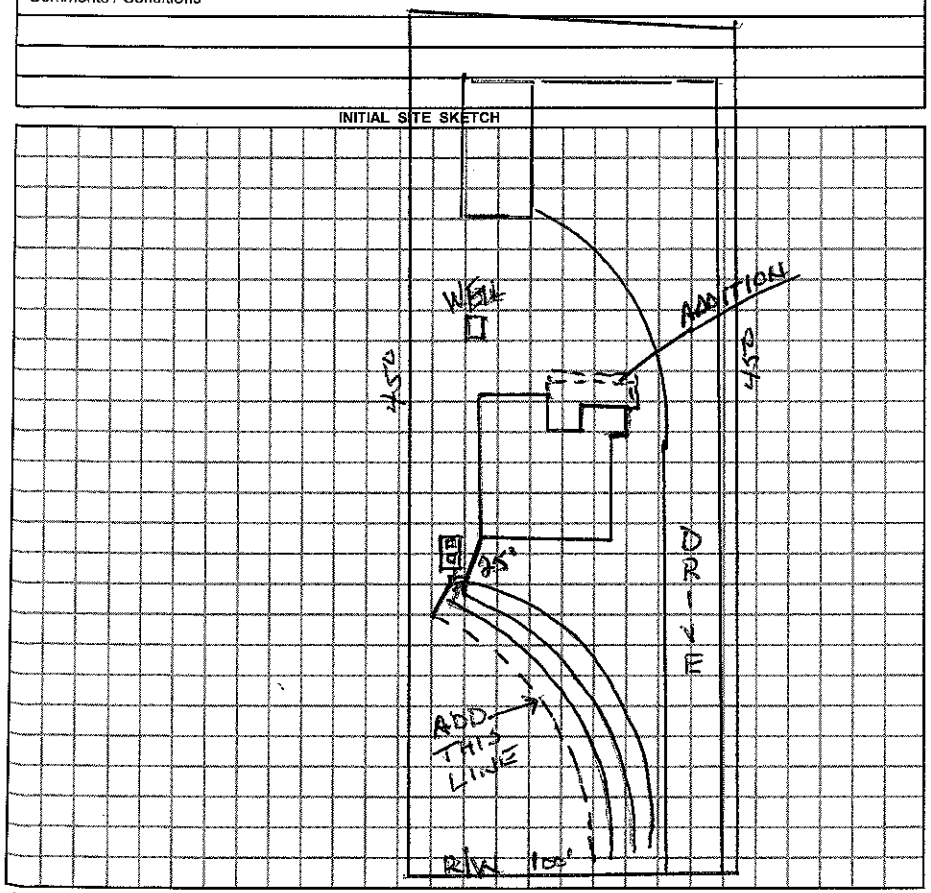

AS BUILT SKETCH

Permit can be suspended or revoked if any false information is supplied toward securing the permit / any unauthorized changes are made to the site / any unauthorized changes are made in the installation of the system.

☐ *IMPROVEMENT PERMIT w / plat valid without expiration.* ☐ *IMPROVEMENT PERMIT w / site plan valid for 60 mos.* ☒ *AUTHORIZATION TO CONSTRUCT valid for period equal to IMPROVEMENT PERMIT-not to exceed 60 mo.*

Owner / Applicant Signature: [signature] Date 9 24 09

Improvement Permit by: Wesley Sparks RS. Date 9/23/09

Authorization to Construct by: Wesley Sparks RS. Date 9/23/09

Installed by: FJ Engin

Operation Permit by: Wesley Sparks RS Date: 9/30/09

Existing System Inspected by: Date:

YOU SHOULD CONTACT A LOCATOR SERVICE PRIOR TO ANY EXCAVATION.

WHITE COPY Environmental Health YELLOW COPY (Final) Owner / Applicant PINK COPY (Initial) Owner / Applicant