IREDELL COUNTY HEALTH DEPARTMENT

Authorization to Construct 4664342789 1 of

STATESVILLE 704-878-5305 MOORESVILLE 704-664-5281

IMPROVEMENT PERMIT / ~~CERTIFICATE OF COMPLETION~~ / OPERATION PERMIT / EXISTING SYSTEM INSPECTION

PROPERTY DESCRIPTION NO. 25389 DATE 10/15/96 TAX MAP NO. 1C A83

OWNER OR CONTRACTOR Ray Brackett PHONE: Business _____ Home _____ Watershed: ☐ Yes ☒ No

ADDRESS Dry Stone Rd. Mooresville, NC. 28115

LOCATION Dry Stone Rd, Sherrills Rd. to end TR 3 mile on (R) - follow drive to house site

SUBDIVISION N/A BLOCK / SECTION _____ LOT 1 LOT AREA ~3 Ac SITE CLASS. PS DESIGN FLOW 480 L.T.A.R. .3

Septic Tank: 1000 Gallons; STB 794 Date 8/10/97

Pump Tank: _____ Gallons; PT _____ Date _____

Pump Make: _____ Model _____ Serial No. _____

Nitrification Field: No Fields 1 Square Feet 1600 Linear Feet 533 (480)

No Lines 5 (4) Trench Width 36" Max Trench Bottom Depth 36" Gravel Depth 36"

☒ New System ☐ Repair System Type: I, II, III, IV, V, VI

System Description: ~~CHB~~ DROP BOX - CH PLASTIC

Repair System Description: SAME

Maintenance Agreement Required: ☐ Yes ☒ No

☒ House/Mod. Home No. Bedrooms 4

☐ Mobile Home No. Bathrooms 3

☐ Business No. Employees _____

☐ Other _____


☐ Slab ☐ Crawl Space ☒ Basement w/plumbing ☐ Basement wo/plumbing

Water Supply: ☒ Individual ☐ Community ☐ Public


Comments: 10/6/97 - Authorized change to 480 feet of Chamber plastic drainfield

Comments:

INITIAL SITE SKETCH

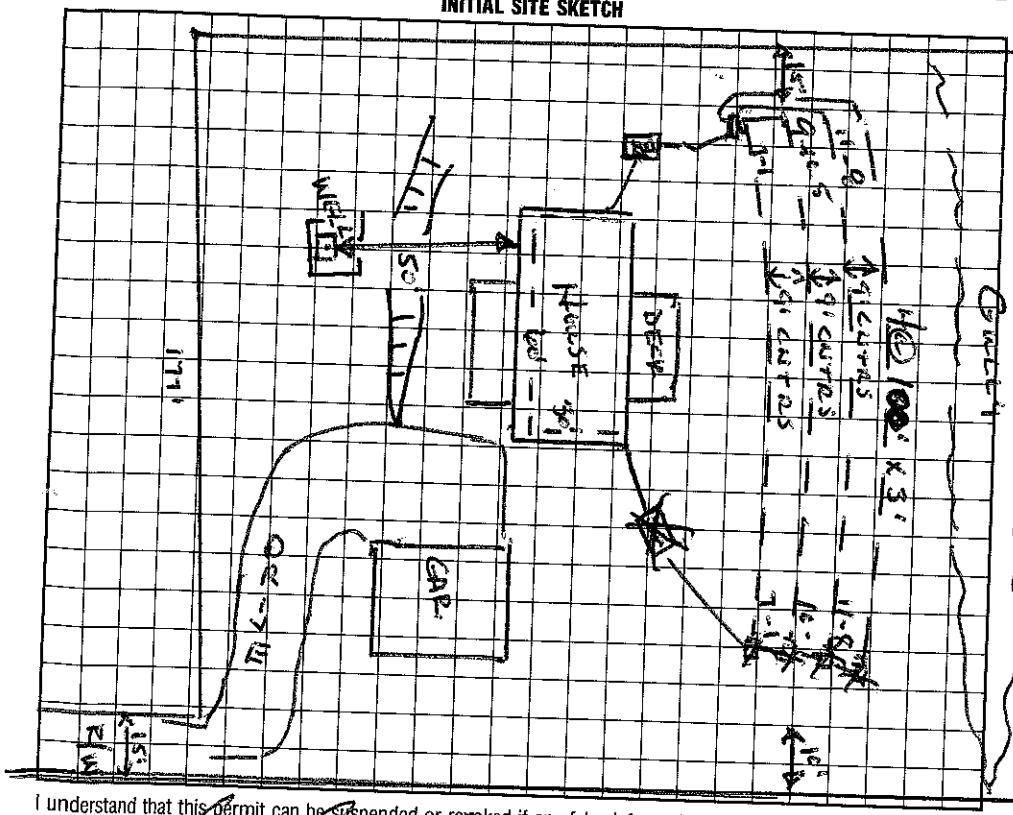

AS BUILT SKETCH

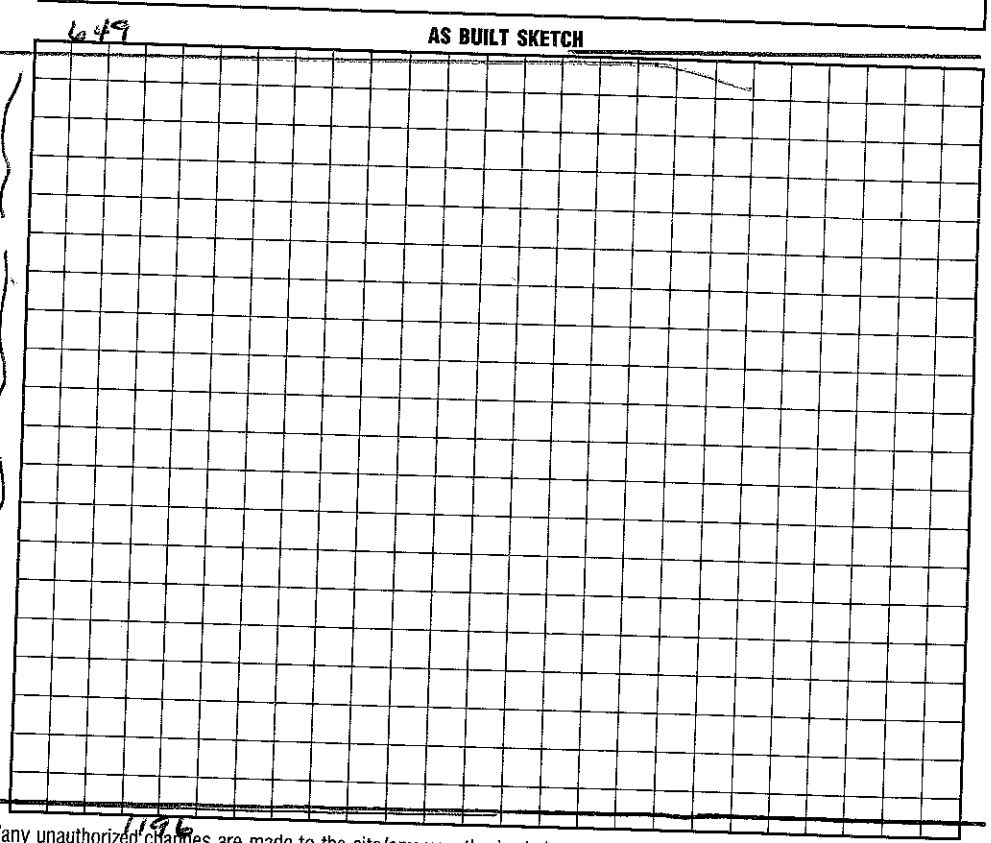

I understand that this permit can be suspended or revoked if any false information is supplied toward securing the permit/any unauthorized changes are made to the site/any unauthorized changes are made in the installation of the system.

Signed: Ray Brackett

Improvement Permit by: Wesley Sparks R.S. date 10/15/96

Existing System Inspection by: Authorized Wesley Sparks R.S. date 10/15/96

Installed by: Ordison Const. Co.

Certificate of Completion by: Wesley Sparks R.S. date 10/7/97

Operation Permit by: Wesley Sparks R.S. date 10/7/97

HEALTH DEPT. COPY: WHITE INSPECTION COPY (FINAL): GREEN OWNER COPY (FINAL): YELLOW INSPECTION COPY (INITIAL): PINK OWNER COPY (INITIAL): GOLD