IREDELL COUNTY HEALTH DEPARTMENT

STATESVILLE 704-878-5305 MOORESVILLE 704-664-5281

4664348669

IMPROVEMENT PERMIT / CERTIFICATE OF COMPLETION / OPERATION PERMIT / EXISTING SYSTEM INSPECTION

PROPERTY DESCRIPTION NO. 13596 DATE 6/28/93 TAX MAP NO. 1C A 611

OWNER OR CONTRACTOR Diane M Beam PHONE: Business Home 664-2090

ADDRESS Greystone Rd. Mooresville, NC.

LOCATION Greystone Rd., end of Stevens TR 3 driveway (R), trailer on (R)

SUBDIVISION BLOCK / SECTION LOT LOT AREA SITE CLASS. L.T.A.R. : 4

Water Supply: ☑ Individual ☐ Community ☐ Public

Septic Tank: 1000 Gallons; STB 358 Date 4/28/93

Pump Tank: Gallons; PT Date

Nitrification Field: No Fields 1 Square Feet 960 Linear Feet 300

No Lines 3 Trench Width 36" Trench Depth 36" Gravel Depth 12"

☐ New System ☐ Repair System Type: I (II) II, IV, V, VI

System Description: CONV.

Repair System Description: CONV.

Maintenance Agreement Required: ☐ Yes ☑ No

☐ House/Mod. Home ☑ Mobile Home ☐ Business ☐ Other

No. Bedrooms 3 No. Bathrooms 2 No. Employees

Garbage Disposal: ☐ Yes ☑ No

Auto. Dishwasher: ☑ Yes ☐ No

Auto. Washing Machine: ☑ Yes ☐ No


Other

☐ Slab ☑ Crawl Space ☐ Basement w/plumbing ☐ Basement wo/plumbing

Comments

INITIAL SITE SKETCH

AS BUILT SKETCH

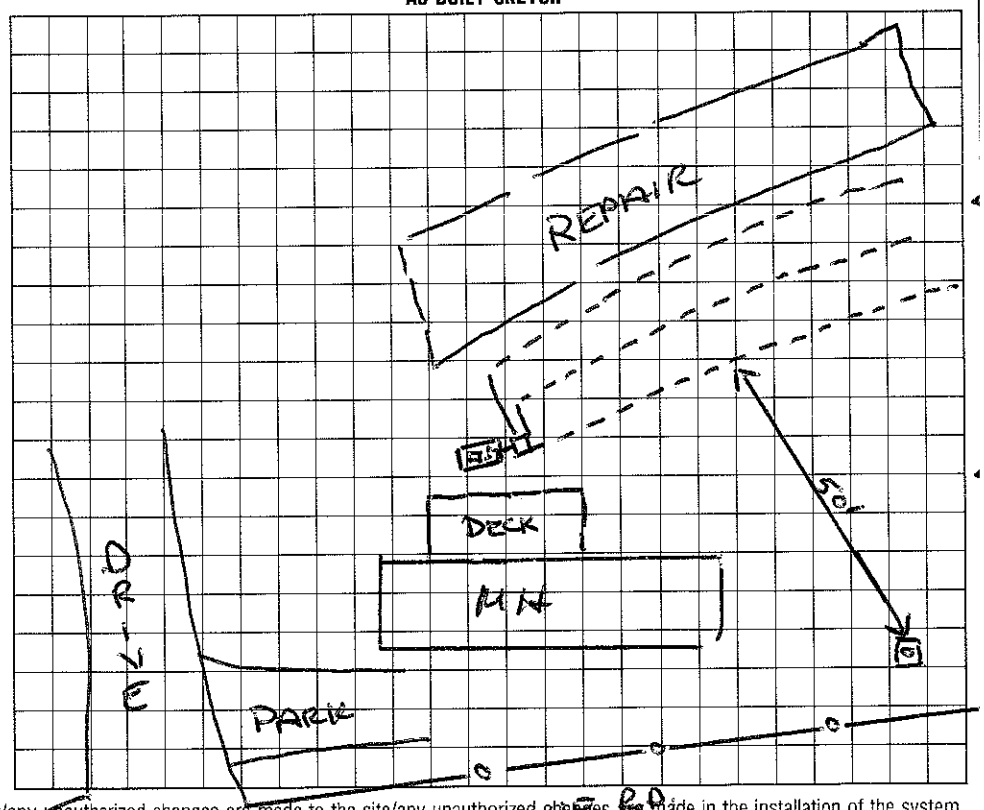

I understand that this permit can be suspended or revoked if any false information is supplied toward securing the permit/any unauthorized changes are made to the site/any unauthorized changes are made in the installation of the system. Improvement Permit is valid for 60 months from date of issuance.

Signed:

Improvement Permit by: date

Existing System Inspection by: date

Installed by: Larry Beam

Certificate of Completion by: Wesley Sparkes. date 6/28/93

Operation Permit by: date

HEALTH DEPT. COPY: WHITE INSPECTION COPY (FINAL): GREEN OWNER COPY (FINAL): YELLOW INSPECTION COPY (INITIAL): PINK OWNER COPY (INITIAL): GOLD