IREDELL COUNTY HEALTH DEPARTMENT

STATESVILLE 704-878-5305 MOORESVILLE 704-664-5281

4664-39-3307

IMPROVEMENT PERMIT / CERTIFICATE OF COMPLETION / OPERATION PERMIT / EXISTING SYSTEM INSPECTION

PROPERTY DESCRIPTION NO. 20345 DATE 3/8/95 TAX MAP NO. IC 5A 10 Watershed: ☐ Yes ☐ No

OWNER OR CONTRACTOR Marty M. Reid PHONE: Business _____ Home 948-0072

ADDRESS 1001 Hagers Rd. Huntersville, NC. 28078

LOCATION Presbyterian Rd. on (R) ~ .4 mile on (R)

SUBDIVISION Gold Trace BLOCK / SECTION _____ LOT 10 LOT AREA ~1.03 Ac. SITE CLASS. P DESIGN FLOW 360 L.T.A.R. .35

Septic Tank: 1000 Gallons; STB 794 Date 4/20/95 ☑ New System ☐ Repair System Type: I, II, (III) IV, V, VI ☑ House/Mod. Home No. Bedrooms 3

Pump Tank: _____ Gallons; PT _____ Date _____ System Description: GRAV PANEL ☐ Mobile Home No. Bathrooms 2

Pump Make: _____ Model _____ Serial No. _____ Repair System Description: SAME ☐ Business No. Employees _____

Nitrification Field: No Fields 1 Square Feet 1028 Linear Feet ~~300~~ Maintenance Agreement Required: ☐ Yes ☐ No ☐ Other _____

No Lines ~~5~~ Trench Width 36" Max Trench Bottom Depth 36" Gravel Depth ~~12"~~ ☐ Slab ☑ Crawl Space ☐ Basement w/plumbing ☐ Basement wo/plumbing


Water Supply: ☑ Individual ☐ Community ☐ Public

Comments: * 16" APBS SYSTEM ON SLOPE CONTOUR. in direction shown.


5/16/95 Authorized 300 sf of fill for drainfield in same area shown on permit. AWS

Comments: 300 sf of fill for

INITIAL SITE SKETCH

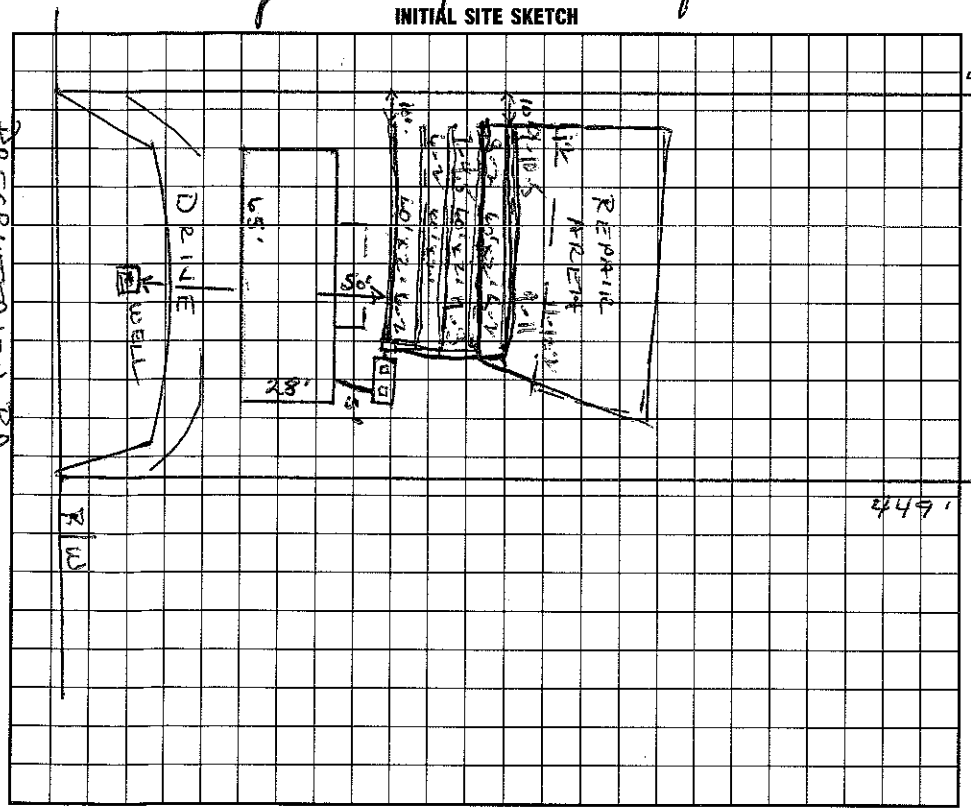

AS BUILT SKETCH

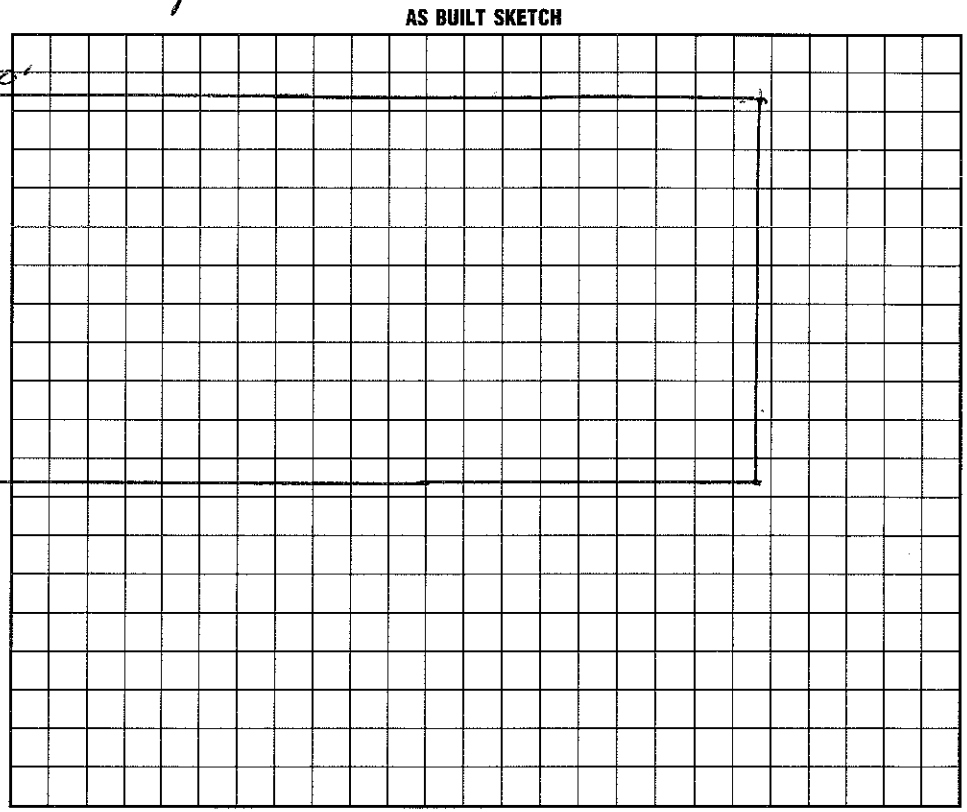

I understand that this permit can be suspended or revoked if any false information is supplied toward securing the permit/any unauthorized changes are made to the site/any unauthorized changes are made in the installation of the system. Improvement Permit is valid for 60 months from date of issuance.

Signed: ✓

Installed by: FJ Erwin

Improvement Permit by: Wesley Sparks R.S. date 3/8/95

Certificate of Completion by: _____ date _____

Existing System Inspection by: Wesley Sparks R.S. date 10/24/95

Operation Permit by: Wesley Sparks R.S. date 10/24/95

Duplicate: Wesley Sparks R.S.

HEALTH DEPT. COPY: WHITE INSPECTION COPY (FINAL): GREEN OWNER COPY (FINAL): YELLOW INSPECTION COPY (INITIAL): PINK OWNER COPY (INITIAL): GOLD