IREDELL COUNTY HEALTH DEPARTMENT

STATESVILLE 704-878-5305 MOORESVILLE 704-664-5281

IMPROVEMENT PERMIT / ~~CERTIFICATE OF COMPLETION~~ / OPERATION PERMIT / EXISTING SYSTEM INSPECTION

PROPERTY DESCRIPTION NO. 26304 DATE 10/7/97 TAX MAP NO. 4664 396317 (7305) Watershed: ☐ Yes ☑ ~~No~~

OWNER OR CONTRACTOR KEVIN SHANK PHONE: Business 892-7217 Home

ADDRESS 655 PRESBYTERIAN RD MOORESVILLE.

LOCATION 115 S. TL PRESBYTERIAN RD - 2½ miles ON RT - FF 655

SUBDIVISION GOLD TRACE BLOCK / SECTION 2 LOT 29 & 30 LOT AREA 2 AC SITE CLASS. PS DESIGN FLOW 360 L.T.A.R. .4 EXISTING

Septic Tank: 1000 Gallons; STB 794 Date 12/24/97

Pump Tank: 1000 Gallons; PT 27 Date 12/23/97

Pump Make: GOULDS Model WE0311L Serial No. A9855379

Nitrification Field: No Fields 1 Square Feet 900 Linear Feet 300

No Lines 3@100 Trench Width ____ Max Trench Bottom Depth ____ Gravel Depth ____

☑ New System ☐ Repair System Type: I, II, (III), IV, V, VI

System Description: PUMP CONVENTIONAL

Repair System Description: SAME

Maintenance Agreement Required: ☐ Yes ☑ ~~No~~

☑ House/Mod. Home No. Bedrooms 3

☐ Mobile Home No. Bathrooms 3

☐ Business No. Employees ____

☐ Other ____


☐ Slab ☐ Crawl Space ☑ Basement w/plumbing ☐ Basement wo/plumbing

Water Supply: ☑ Individual ☐ Community ☐ Public

Comments: SET NEW SEPTIC TANK & PUMP TANK. PUMP TO OLD EXISTING SYSTEM

Comments:

INITIAL SITE SKETCH

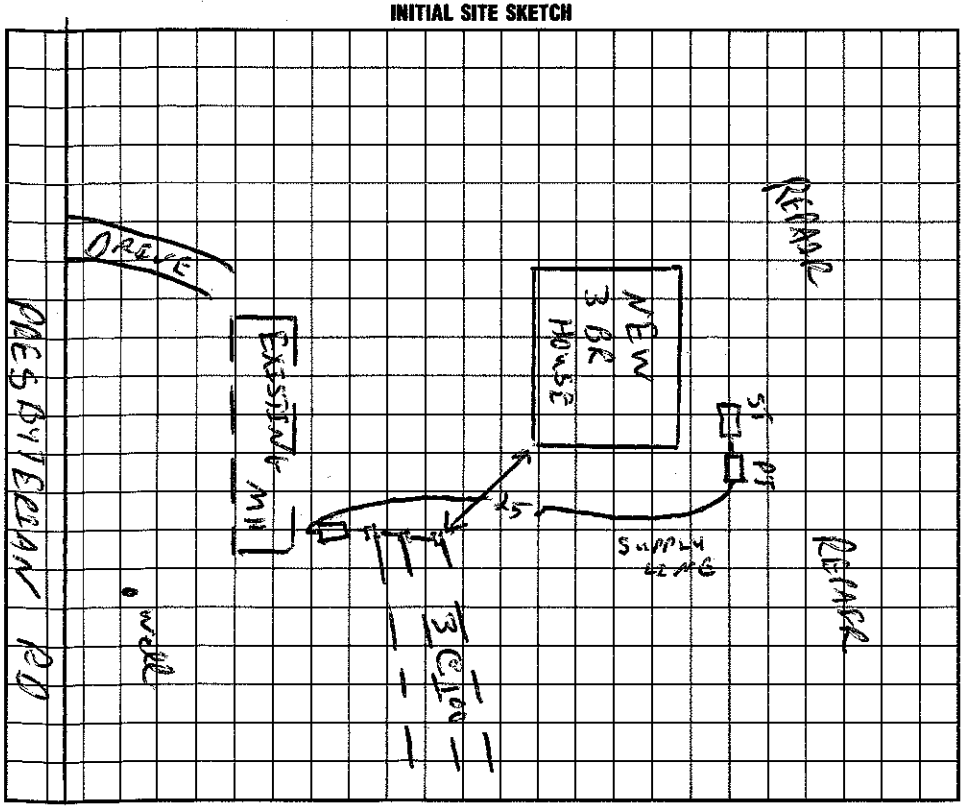

AS BUILT SKETCH

I understand that this permit can be suspended or revoked if any false information is supplied toward securing the permit/any unauthorized changes are made to the site/any unauthorized changes are made in the installation of the system. Improvement Permit is valid for 60 months from date of issuance.

Signed: Clara F. Shank

Installed by: FS ERVIN

Improvement Permit by: C. Ray Tom RS date 10/7/97

Certificate of Completion by: ____ date ____

~~Existing System Inspection by:~~ C. Ray Tom RS date 10/7/97

Operation Permit by: C. Ray Tom date 5/6/98

HEALTH DEPT. COPY: WHITE INSPECTION COPY (FINAL): GREEN OWNER COPY (FINAL): YELLOW INSPECTION COPY (INITIAL): PINK OWNER COPY (INITIAL): GOLD