IREDELL COUNTY HEALTH DEPARTMENT

STATESVILLE 704-878-5305 MOORESVILLE 704-664-5281

IMPROVEMENT PERMIT / AUTHORIZATION TO CONSTRUCT / OPERATION PERMIT / EXISTING SYSTEM INSPECTION

PERMIT# 122604 PIN# 4664 39 9768 DATE 9/11/06

OWNER OR APPLICANT Harold Priestley PHONE: Business 704-608-8275 Home

ADDRESS 3100 Kingsmouth Rd. Charlotte, NC. 28269

LOCATION Shepherds Rd. TR Huntington Ridge, 6th lot on (L)

SUBDIVISION Huntington Ridge BLOCK / SECTION LOT 13 LOT AREA 1.025 AC SITE CLASS. PS DESIGN FLOW 480 L.T.A.R. .25

Septic Tank: 1000 Gallons; STB 317 Date 3/27/07

Pump Tank: 1000 Gallons; PT 27 Date 4/24/07

Pump Make: Gouldes Model WEO-10 1/2 Serial No. 10105

Nitrification Field: No Fields 1 Square Feet 960 Linear Feet 320

No Lines ~~4~~ 5 Trench Width 3' Max. Trench Bottom Depth 30" Gravel Depth No ☐ Gravity ☐ Pressure

☒ New System ☐ Repair ☐ Expansion System Type: I II III IV V VI

System Description: LP - 16" PPBPS

Repair System Description: SAME TYPE

Maintenance Agreement Required: ☒ Yes ☐ No

☒ House/Mod. Home ☐ Mobile Home ☐ Business ☐ Other

No. Bedrooms 4 No. Persons No. Employees

Water Supply: ☒ Individual ☐ Public ☐ Community


☐ Slab ☐ Crawl Space ☒ Basement w/plumbing ☐ Basement wo/plumbing

Comments:/Conditions: 5 lines x 64' x 3 x 9' oc


Comments:/Conditions:

(1" = 50')

INITIAL SITE SKETCH

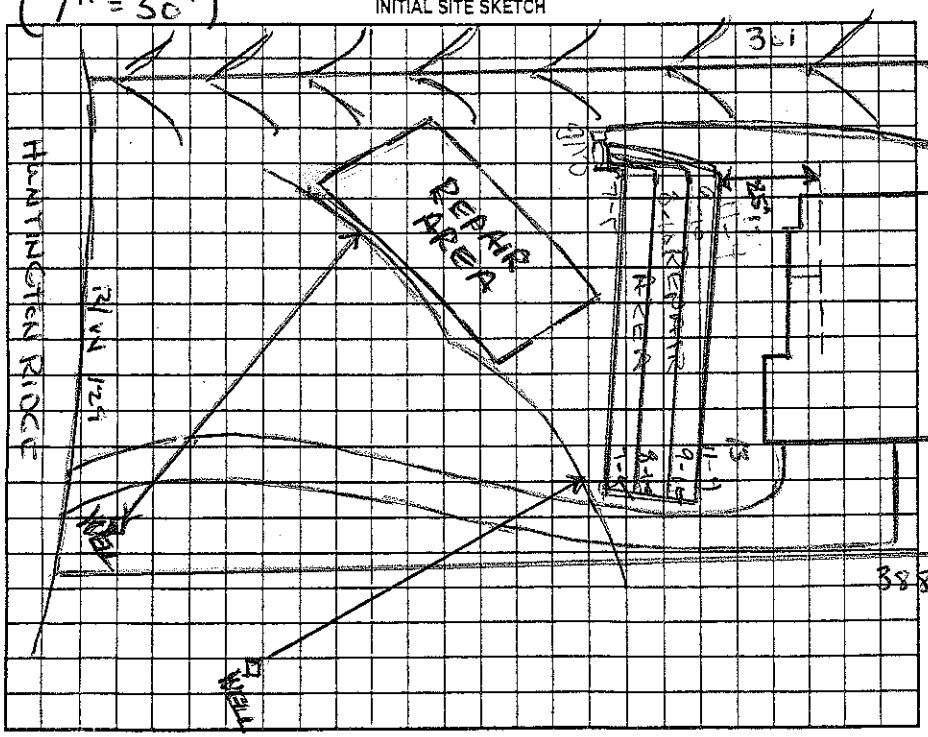

AS BUILT SKETCH

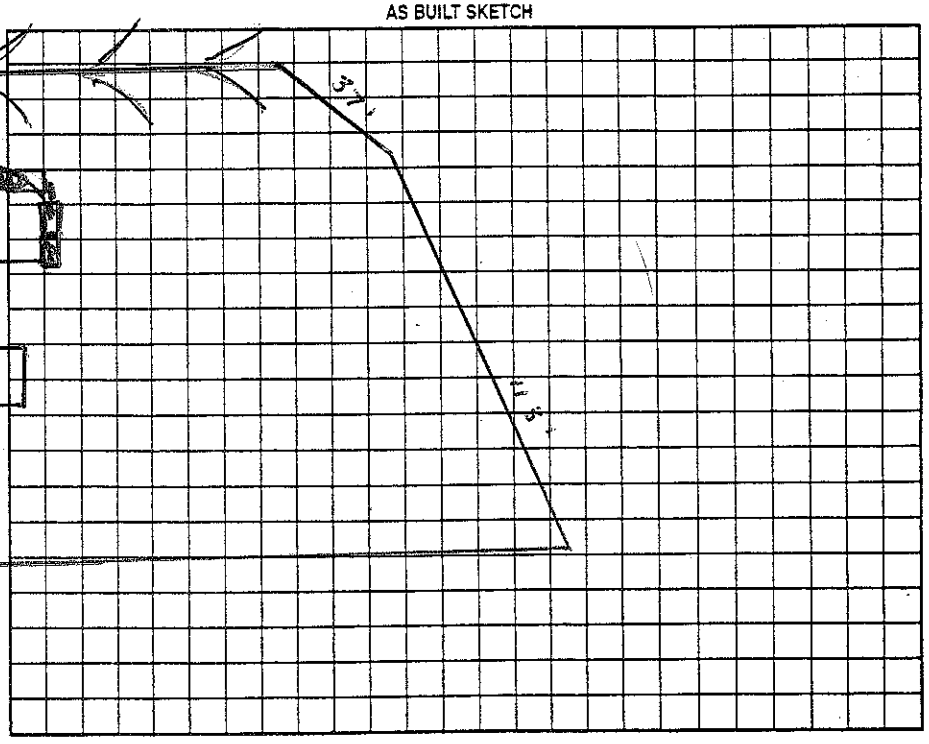

Permit can be suspended or revoked if any false information is supplied toward securing the permit/any unauthorized changes are made to the site/any unauthorized changes are made in the installation of the system. Improvement Permit with plat valid without expiration ☐ Improvement Permit with site plan valid for sixty months ☐ Authorization to Construct is valid for a period equal to that of Improvement Permit – not to exceed sixty months.

Signed: Jerry M Miner date 9/14/06 Installed by: FT Erwin

Improvement Permit by: Wesley Sparks R.S. date 9/12/06 Operation Permit by: Wesley Sparks R.S. date 9/5/07

Authorization to Construct by: Wesley Sparks R.S. date 9/12/06 Existing System Inspection by: date

HEALTH DEPT. COPY: WHITE OWNER COPY (FINAL): YELLOW OWNER COPY (INITIAL): PINK