IREDELL COUNTY HEALTH DEPARTMENT

STATESVILLE 704-878-5305 ☒MOORESVILLE 704-664-5281

IMPROVEMENT PERMIT / AUTHORIZATION TO CONSTRUCT / OPERATION PERMIT / EXISTING SYSTEM INSPECTION

PERMIT # 174110 PIN # 4664-44-4667 DATE 9-5-12

OWNER or APPLICANT MARK MORGAN PHONE: Business 704-582-3818 Home:

OWNER or APPLICANT ADDRESS 14101 BLACK FARMS RD HUNTERSVILLE

LOCATION / DIRECTIONS SHEARERS, TR GREYSTONE, 138

SUBDIVISION INGLE BLOCK / SECTION LOT # TR 1 LOT AREA .624AC DESIGN FLOW 360 L.T.A.R. .375R

Septic Tank 1000 Gallons: STB 1012 Date 3-12

Pump Tank Gallons: PT Date

Pump Make Model Serial #

Nitrification Field No Fields 1 No Lines 4 Linear Feet 200'

Trench Width 24-36" Max. Trench Bottom Depth 36" Gravel Depth –

☒ New System ☐ Repair ☐ Expansion System Type I II (III) IV V VI

System Description: GRAVITY PANEL

Repair System Description: LP- PANEL

Maintenance Agreement Required ☐ YES ☒ NO

☒ GRAVITY ☐ PRESSURE

☒ Residence No. Bedrooms 3

☐ Business No. Persons

☐ Other No. Employees

☐ Slab ☒ Crawl Space


☐ Basement w/plumbing ☐ Basement w/o plumbing

Water Supply: ☒ Private ☐ Public ☐ Community


Comments / Conditions

Comments / Conditions

INITIAL SITE SKETCH

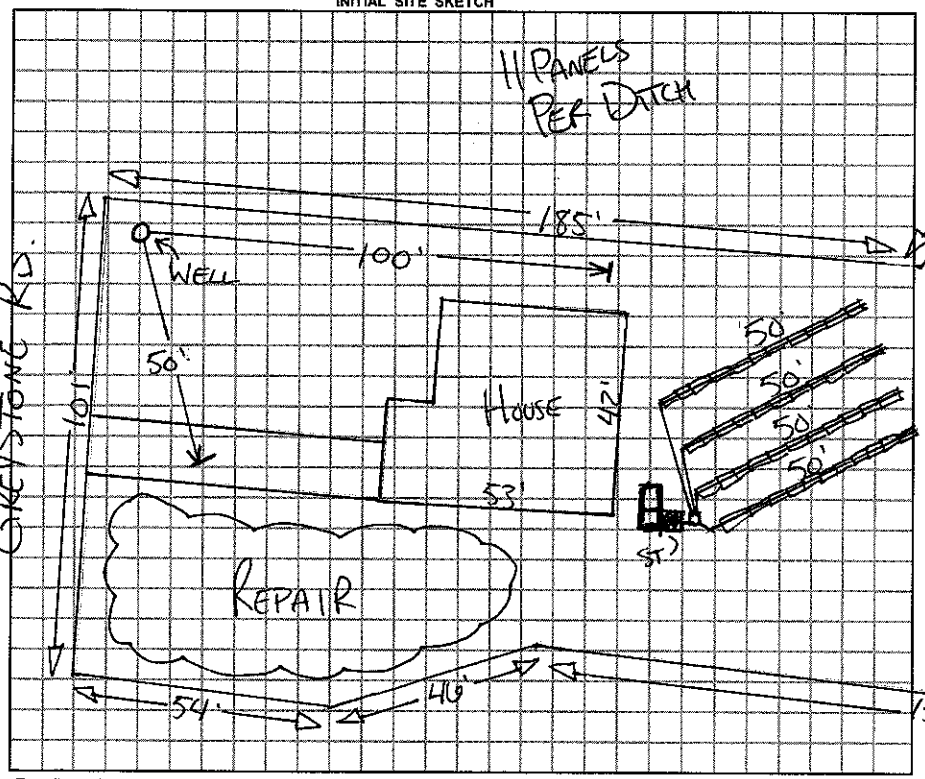

AS BUILT SKETCH

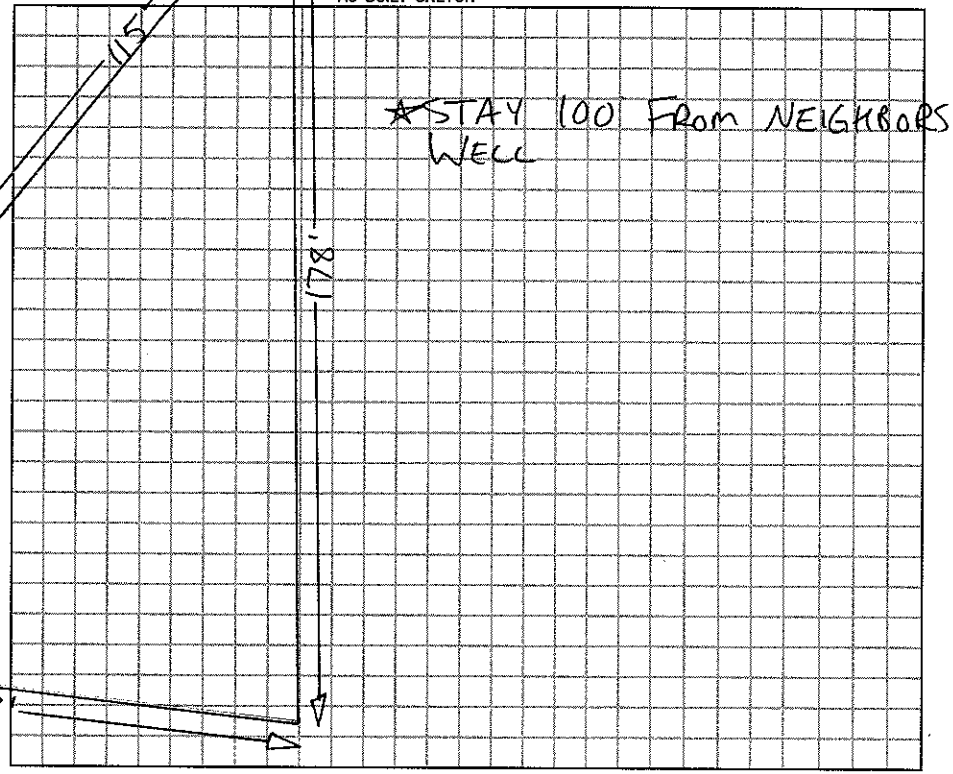

Permit can be suspended or revoked if any false information is supplied toward securing the permit / any unauthorized changes are made to the site / any unauthorized changes are made in the installation of the system.

☐ *IMPROVEMENT PERMIT w / plat valid without expiration.* ☒ *IMPROVEMENT PERMIT w / site plan valid for 60 mos.* ☒ *AUTHORIZATION TO CONSTRUCT valid for period equal to IMPROVEMENT PERMIT not to exceed 60 mo.*

Owner / Applicant Signature: Date 9-12-12

Improvement Permit by: REHS Date 9-5-12

Authorization to Construct by: REHS Date 9-5-12

Installed by: Tommy Fry

Operation Permit by: Date: 1-11-13

Existing System Inspected by: Date:

YOU SHOULD CONTACT A LOCATOR SERVICE PRIOR TO ANY EXCAVATION.

WHITE COPY Environmental Health YELLOW COPY (Final) Owner / Applicant PINK COPY (Initial) Owner / Applicant