IREDELL COUNTY HEALTH DEPARTMENT

AUTHORIZATION TO CONSTRUCT Instant Grading $100 3.00

STATESVILLE 704-878-5305 MOORESVILLE 704-664-5281

IMPROVEMENT PERMIT / ~~CERTIFICATE OF COMPLETION~~ / OPERATION PERMIT / EXISTING SYSTEM INSPECTION

PROPERTY DESCRIPTION NO. 068318 DATE 8/20/97 TAX MAP NO. 4664-44-7661 (#124) Watershed: ☑ Yes ☐ No

OWNER OR CONTRACTOR STACY INGLE ~~PHONE: Business~~ 4664-44-6672 (#128) Home 876-8542

ADDRESS 124 GREYSTONE DR

LOCATION SHEARERS RD - TR GREYSTONE 2ND LOT ON RT

SUBDIVISION — BLOCK / SECTION — LOT — LOT AREA — SITE CLASS. PS DESIGN FLOW 360 L.T.A.R. .35 GPD/FT

Septic Tank: 1060 Gallons; STB RST 825 Date 7-11-97

Pump Tank: _____ Gallons; PT _____ Date _____

Pump Make: _____ Model _____ Serial No. _____

Nitrification Field: No Fields 1 Square Feet 513 Linear Feet 171

No Lines 3@57' Trench Width 24" Max Trench Bottom Depth 36" Gravel Depth N/A

☑ New System ☐ Repair System Type: I, II, III, IV, V, VI

System Description: GRAVITY PANEL

Repair System Description: SAME

Maintenance Agreement Required: ☐ Yes ☑ No

☐ House/Mod. Home No. Bedrooms 3

☑ Mobile Home No. Bathrooms 3

☐ Business No. Employees ____

☐ Other _____


☐ Slab ☑ Crawl Space ☐ Basement w/plumbing ☐ Basement wo/plumbing

Water Supply: ☑ Individual ☐ Community ☐ Public

Comments:

Comments:
9-3-97 Checked upper lateral & Tank OK

INITIAL SITE SKETCH

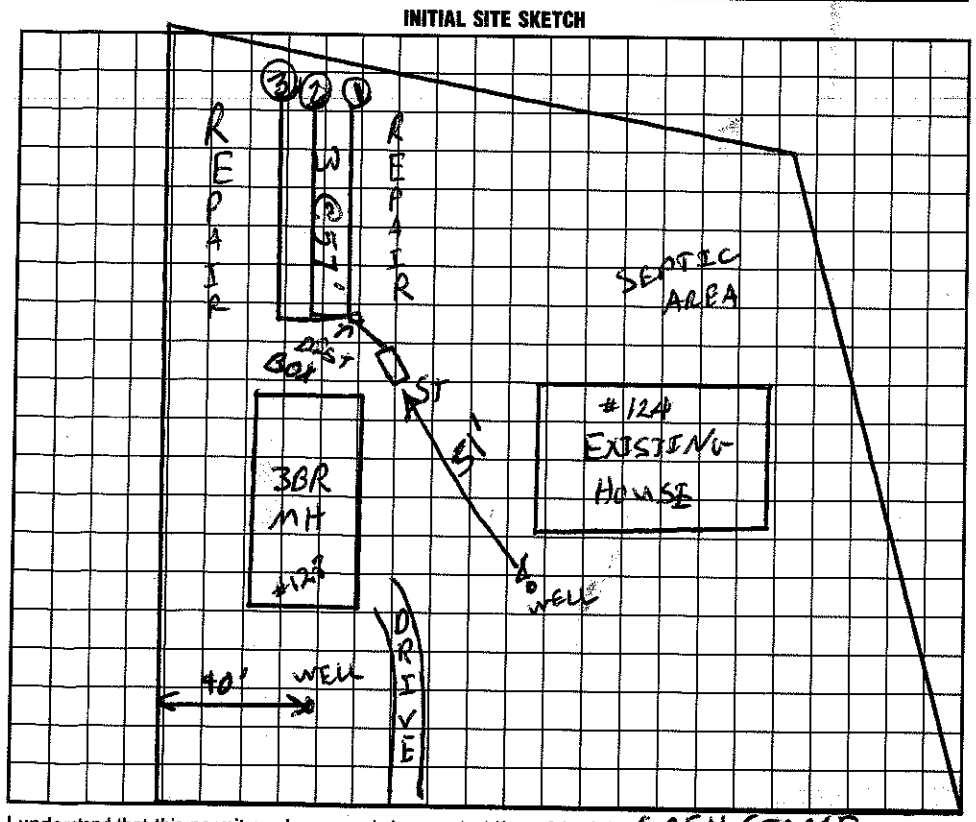

AS BUILT SKETCH

SAME AS SITE SKETCH

I understand that this permit can be suspended or revoked if any false information is supplied toward securing the permit/any unauthorized changes are made to the site/any unauthorized changes are made in the installation of the system. Improvement Permit is valid for 60 months from date of issuance.

Signed: Stacy Ingle

Improvement Permit by: AUTHORIZATION C. Thy Green date 8/20/97

~~Existing System Inspection by:~~ C. Thy Green date 8/20/97

Installed by: PIEDMONT SEPTIC

Certificate of Completion by: _____ date _____

Operation Permit by: C. Thy Green date 9/4/97

? CONSTRUCT

HEALTH DEPT. COPY: WHITE INSPECTION COPY (FINAL): GREEN OWNER COPY (FINAL): YELLOW INSPECTION COPY (INITIAL): PINK OWNER COPY (INITIAL): GOLD