IREDELL COUNTY HEALTH DEPARTMENT

STATESVILLE 704-878-5305 MOORESVILLE 704-664-5281

IMPROVEMENT PERMIT / CERTIFICATE OF COMPLETION / OPERATION PERMIT / EXISTING SYSTEM INSPECTION

PROPERTY DESCRIPTION NO. 16504 DATE 6/21/93

OWNER OR CONTRACTOR MICHAEL T INGLE PHONE: Business

ADDRESS 103 #3 CABARRUS AVE MOORESVILLE, NC 28115 TAX MAP NO. 1B A 54

LOCATION SHEARERS RD ON (R) ~4½ MILES FROM CITY LIMITS Home 663-7822

SUBDIVISION BLOCK / SECTION LOT LOT AREA SITE CLASS. L.T.A.R.

Water Supply: ☑ Individual ☐ Community ☐ Public

Septic Tank: 1000 Gallons; STB 358 Date 4-22-93

Pump Tank: Gallons; PT Date

Nitrification Field: No Fields 1 Square Feet 1350 Linear Feet 450

No Lines 5 Trench Width 3' Trench Depth 36" Gravel Depth 12"

☑ New System ☐ Repair System Type: I, (II), III, IV, V, VI

System Description: CONV.

Repair System Description: CONV.

Maintenance Agreement Required: ☐ Yes ☑ No

☐ House/Mod. Home ☑ Mobile Home ☐ Business ☐ Other

No. Bedrooms 3 No. Bathrooms 2 No. Employees

☐ Slab ☑ Crawl Space ☐ Basement w/plumbing

Garbage Disposal: ☐ Yes ☑ No

Auto. Dishwasher: ☑ Yes ☐ No

Auto. Washing Machine: ☑ Yes ☐ No


Other

☐ Basement wo/plumbing

Comments DROP BOXES MAY BE USED - TRENCHES NOT DEEPER THAN 36" TO TRENCH BOTTOM - LINES ON CONTOUR IN DIRECTION SHOWN

Stepdowns in upper two trenches DRB

INITIAL SITE SKETCH

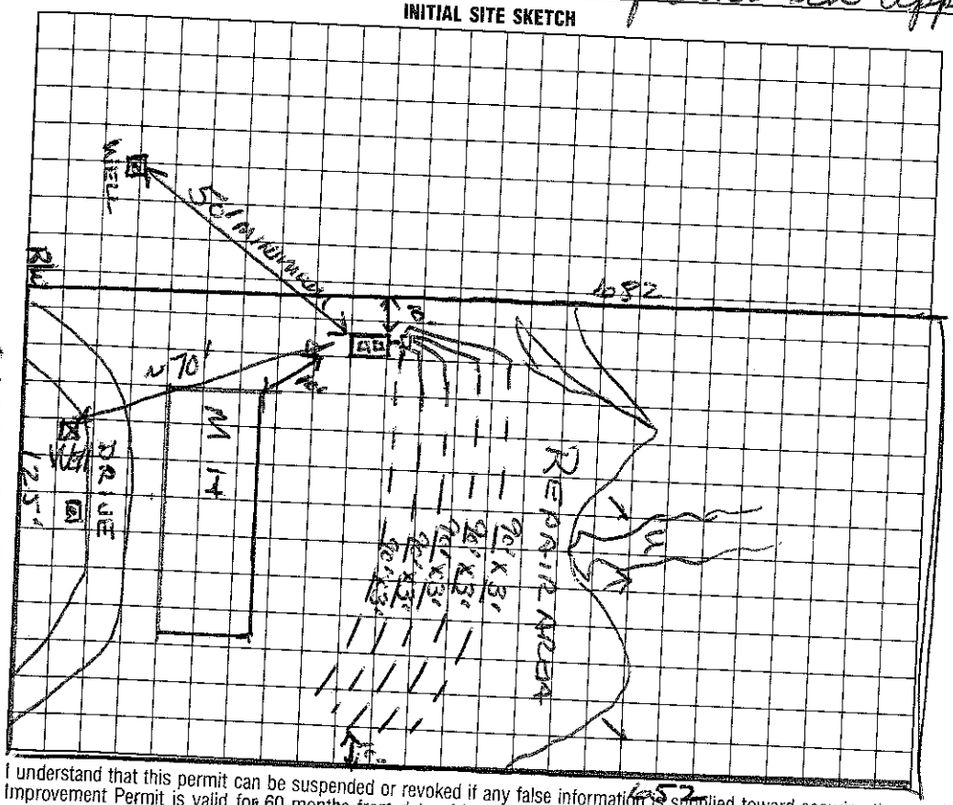

AS BUILT SKETCH

As shown on initial sketch

I understand that this permit can be suspended or revoked if any false information is supplied toward securing the permit/any unauthorized changes are made to the site/any unauthorized changes are made in the installation of the system. Improvement Permit is valid for 60 months from date of issuance.

Signed: Michael T. Ingle

Improvement Permit by: Wesley Sparks R.S. date 6/23/93

Existing System Inspection by: date

Installed by: Wayne Potter

Certificate of Completion by: David B. Hammer, RS date 7-7-93

Operation Permit by: date

HEALTH DEPT. COPY: WHITE INSPECTION COPY (FINAL): GREEN OWNER COPY (FINAL): YELLOW INSPECTION COPY (INITIAL): PINK OWNER COPY (INITIAL): GOLD