IREDELL COUNTY HEALTH DEPARTMENT

Authorization to Construct 4604458358

STATESVILLE 704-878-5305 MOORESVILLE 704-664-5281

IMPROVEMENT PERMIT / ~~CERTIFICATE OF COMPLETION~~ / OPERATION PERMIT / EXISTING SYSTEM INSPECTION

PROPERTY DESCRIPTION NO. 23609 DATE 5/6/96 TAX MAP NO. part of 1BA65 Watershed: ☐ Yes ☒ No

OWNER OR CONTRACTOR Linda W Fetherston PHONE: Business 892-3614 Home

ADDRESS 1791 Sherrills Rd. Davidson, NC 28036

LOCATION on (L) of Sherrills Rd. before City line.

SUBDIVISION N/A BLOCK / SECTION LOT N/A LOT AREA SITE CLASS. PS DESIGN FLOW 240 L.T.A.R. .25

Septic Tank: 1000 Gallons; STB 794 Date 1-11-95

Pump Tank: Gallons; PT Date

Pump Make: Model Serial No.

Nitrification Field: No Fields 1 Square Feet 960 Linear Feet 320

No Lines 5 Trench Width 36" Max Trench Bottom Depth 36" Gravel Depth 12"

☒ New System ☐ Repair System Type: I (II) III. IV. V. VI

System Description: Conventional - Dot Box

Repair System Description: Same

Maintenance Agreement Required: ☐ Yes ☒ No

☐ House/Mod. Home ☒ Mobile Home ☐ Business ☐ Other

No. Bedrooms 2 No. Bathrooms 2 No. Employees


Water Supply: ☒ Individual ☐ Community ☐ Public

☐ Slab ☒ Crawl Space ☐ Basement w/plumbing ☐ Basement wo/plumbing

Comments:

Comments:

INITIAL SITE SKETCH

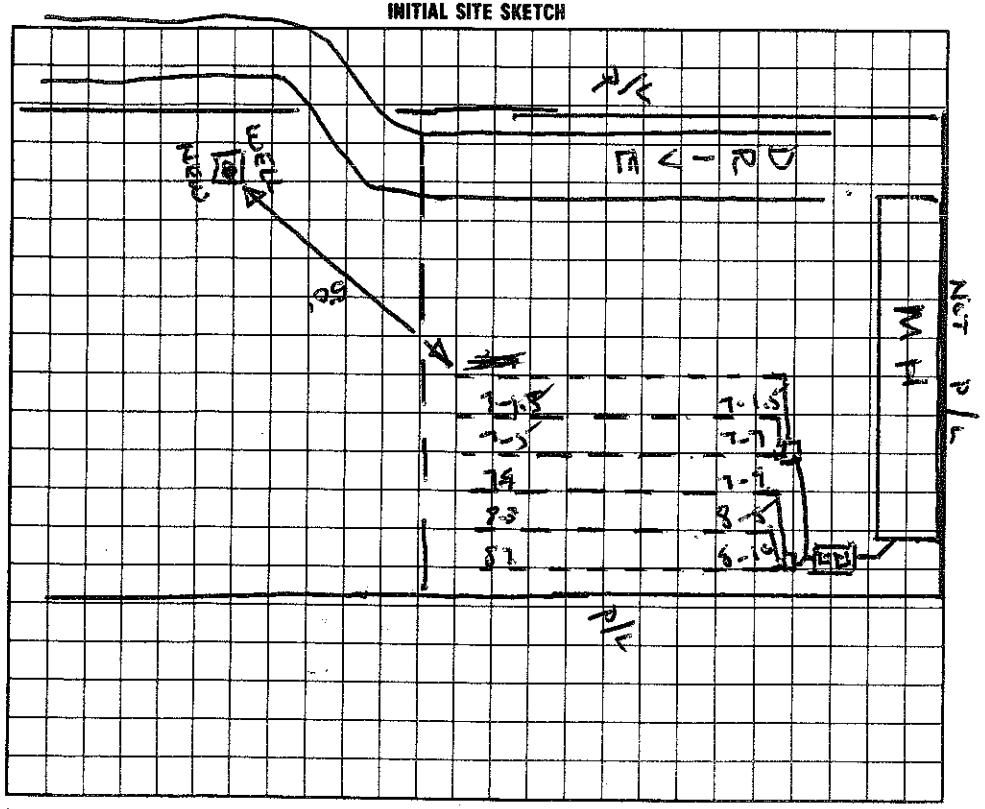

AS BUILT SKETCH

I understand that this permit can be suspended or revoked if any false information is supplied toward securing the permit/any unauthorized changes are made to the site/any unauthorized changes are made in the installation of the system.

Signed: ~~X~~ Jimmy Fetherston

Improvement Permit by: Wesley Sparks RS. date 5/6/96

Authorization to Construct: Wesley Sparks RS. date 5/6/96

Installed by: Larry Beam

Certificate of Completion by: date

Operation Permit by: Wesley Sparks RS. date 5/20/96

HEALTH DEPT. COPY: WHITE INSPECTION COPY (FINAL): GREEN OWNER COPY (FINAL): YELLOW INSPECTION COPY (INITIAL): PINK OWNER COPY (INITIAL): GOLD