4664-47-1222

IREDELL COUNTY HEALTH DEPARTMENT

STATESVILLE 704-878-5305 MOORESVILLE 704-664-5281

IMPROVEMENT PERMIT / CERTIFICATE OF COMPLETION / OPERATION PERMIT / EXISTING SYSTEM INSPECTION

PROPERTY DESCRIPTION NO. 18954 DATE _____ TAX MAP NO. 18 - A - 93 Watershed: ☐ Yes ☒ No

OWNER OR CONTRACTOR Lee Easter Dev. PHONE: Business 664 - 2906 Home _____

ADDRESS 227 Hideaway Ln. Mooresville, NC.

LOCATION Shearers Chapel on (R) past Presbyterian Rd (R) to 5th lot on (L)

SUBDIVISION Country Court BLOCK / SECTION 1 LOT 6 LOT AREA ~.59 Ac SITE CLASS. P DESIGN FLOW 360 L.T.A.R. .3

Septic Tank: 1000 Gallons; STB 794 Date 12/5/95

Pump Tank: _____ Gallons; PT _____ Date _____

Pump Make: _____ Model _____ Serial No. 300

Nitrification Field: No Fields 1 Square Feet 1200 Linear Feet ~~240~~

No Lines ~~3~~ 4 Trench Width 24" Max Trench Bottom Depth 36" Gravel Depth 6" SAND

☒ New System ☐ Repair System Type: I, II, (III) IV, V, VI

System Description: Chemland Plastic

Repair System Description: Panel Repair

Maintenance Agreement Required: ☐ Yes ☐ No

☒ House/Mod. Home No. Bedrooms 3

☐ Mobile Home No. Bathrooms 2

☐ Business No. Employees _____

☐ Other _____


☐ Slab ☐ Crawl Space ☐ Basement w/plumbing ☐ Basement wo/plumbing

Water Supply:
☐ Individual
☐ Community
☐ Public


Comments: 16" PPBS Drainfield Required
Lot "U" if conventional trenches used.
Flow Divider Required each run

Comments:
3/14/96 - Changed to Chemland Plastic 300' with sand fill

INITIAL SITE SKETCH

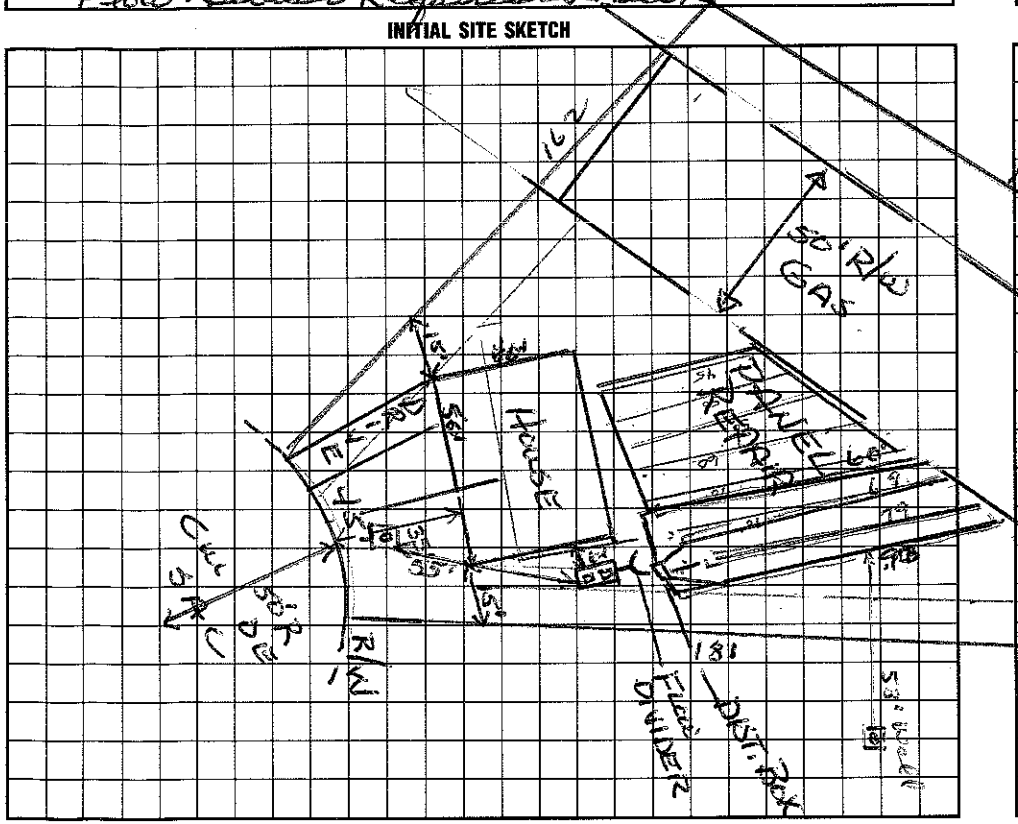

AS BUILT SKETCH

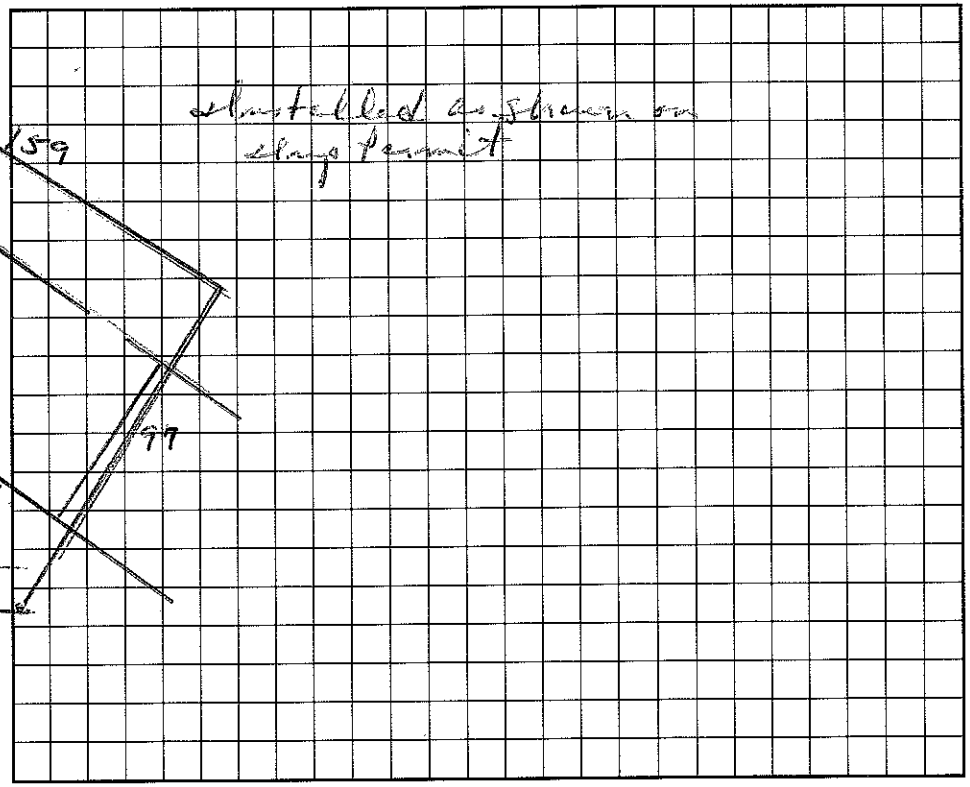

I understand that this permit can be suspended or revoked if any false information is supplied toward securing the permit/any unauthorized changes are made to the site/any unauthorized changes are made in the installation of the system. Improvement Permit is valid for 60 months from date of issuance.

Signed: D. Lee Easter Dan Easter Develop Corp.

Improvement Permit by: Wesley Sparks R.S. date 1/30/95

Existing System Inspection by: _____ date _____

Installed by: Chet Dawning

Certificate of Completion by: _____ date _____

Operation Permit by: Wesley Sparks R.S. date 3/15/96

HEALTH DEPT. COPY: WHITE INSPECTION COPY (FINAL): GREEN OWNER COPY (FINAL): YELLOW INSPECTION COPY (INITIAL): PINK OWNER COPY (INITIAL): GOLD