4664471937

IREDELL COUNTY HEALTH DEPARTMENT

STATESVILLE 704-878-5305 MOORESVILLE 704-664-5281

IMPROVEMENT PERMIT / CERTIFICATE OF COMPLETION / OPERATION PERMIT / EXISTING SYSTEM INSPECTION

PROPERTY DESCRIPTION NO. 17834 DATE 2/23/94 TAX MAP NO. 13-A-25 Watershed: ☑ Yes ☐ No

OWNER OR CONTRACTOR Paul Edward Pruitt PHONE: Business _____ Home 896-0358

ADDRESS Rt 1 Box 756-AA Davidson, NC 28036

LOCATION Shearers Rd, to 3rd drive past Presbyterian Rd., TR. ~.2 mile from road on ®

SUBDIVISION N/A BLOCK / SECTION _____ LOT _____ LOT AREA ~5Ac SITE CLASS. P DESIGN FLOW _____ L.T.A.R. _____

Septic Tank: 1000 Gallons; STB _____ Date _____

Pump Tank: _____ Gallons; PT _____ Date _____

Pump Make: _____ Model _____ Serial No. _____

Nitrification Field: No Fields 1 Square Feet 600 Linear Feet 200

No Lines 2 Trench Width 3' Max Trench Bottom Depth 36" Gravel Depth _____

☑ New System ☐ Repair System Type: I, II, III, IV, V, VI

System Description: Add - 200' conv. w/ D-Box

Repair System Description: _____

Maintenance Agreement Required: ☐ Yes ☑ No

☑ House/Mod. Home No. Bedrooms 3

☐ Mobile Home No. Bathrooms 2

☐ Business No. Employees _____

☐ Other _____


☐ Slab ☑ Crawl Space ☐ Basement w/plumbing ☐ Basement wo/plumbing

Water Supply: ☑ Individual ☐ Community ☐ Public

Comments: 1 - SLEEVE SCH40 PVC IN 6" DOT STA CULVERT UNDER PARKING DRIVE

Comments: 10/12/94 Inspected drainfield - O.K. AWS

INITIAL SITE SKETCH

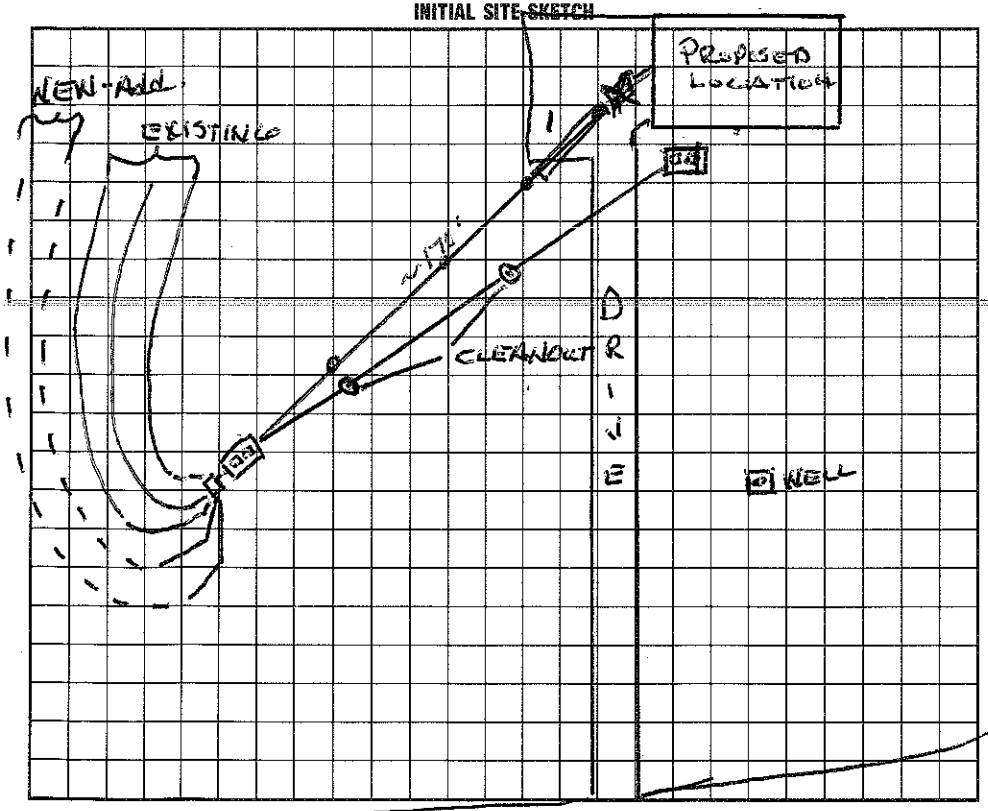

AS BUILT SKETCH

I understand that this permit can be suspended or revoked if any false information is supplied toward securing the permit/any unauthorized changes are made to the site/any unauthorized changes are made in the installation of the system. Improvement Permit is valid for 60 months from date of issuance.

Signed: _____ GRAVEL DRIVE

Improvement Permit by: W. Dudley Sparks R.S. date 2/23/94

Existing System Inspection by: _____ date _____

Installed by: Richard Abernathy

Certificate of Completion by: W. Dudley Sparks R.S. date 10/24/94

Operation Permit by: _____ date _____

HEALTH DEPT. COPY: WHITE INSPECTION COPY (FINAL): GREEN OWNER COPY (FINAL): YELLOW INSPECTION COPY (INITIAL): PINK OWNER COPY (INITIAL): GOLD