PIN# 4664-47-2175

IREDELL COUNTY HEALTH DEPARTMENT

STATESVILLE 704-878-5305 MOORESVILLE 704-664-5281

IMPROVEMENT PERMIT / CERTIFICATE OF COMPLETION / OPERATION PERMIT / EXISTING SYSTEM INSPECTION

PROPERTY DESCRIPTION NO. ~~IB A-93~~ 18955 DATE 1/29/95 TAX MAP NO. 18-A-93 Watershed: ☐ Yes ☑ No

OWNER OR CONTRACTOR Lee Easter Development PHONE: Business 664-2906 Home

ADDRESS 227 Hideaway Ln.

LOCATION Shearon Chapel Rd. on (R) past Presbyterian Rd. (R) to 4th lot on (L)

SUBDIVISION Country Forest BLOCK / SECTION 1 LOT 7 LOT AREA ~.62AC SITE CLASS. P DESIGN FLOW 360 L.T.A.R. .3

Septic Tank: 1000 Gallons; STB 794 Date 11/22/95

Pump Tank: Gallons; PT Date

Pump Make: Model Serial No.

Nitrification Field: No Fields 1 Square Feet 1200 Linear Feet 400

No Lines 4 Trench Width 36" Max Trench Bottom Depth 36" Gravel Depth 12"

☑ New System ☐ Repair System Type: I, (II), III, IV, V, VI

System Description: DROP BOX - CONVENTIONAL

Repair System Description: 16' PPBS

Maintenance Agreement Required: ☐ Yes ☑ No

☑ House/Mod. Home No. Bedrooms 3

☐ Mobile Home No. Bathrooms 2

☐ Business No. Employees

☐ Other


☐ Slab ☐ Crawl Space ☑ Basement w/plumbing ☐ Basement wo/plumbing

Water Supply: ☑ Individual ☐ Community ☐ Public


Comments:

Comments:

INITIAL SITE SKETCH

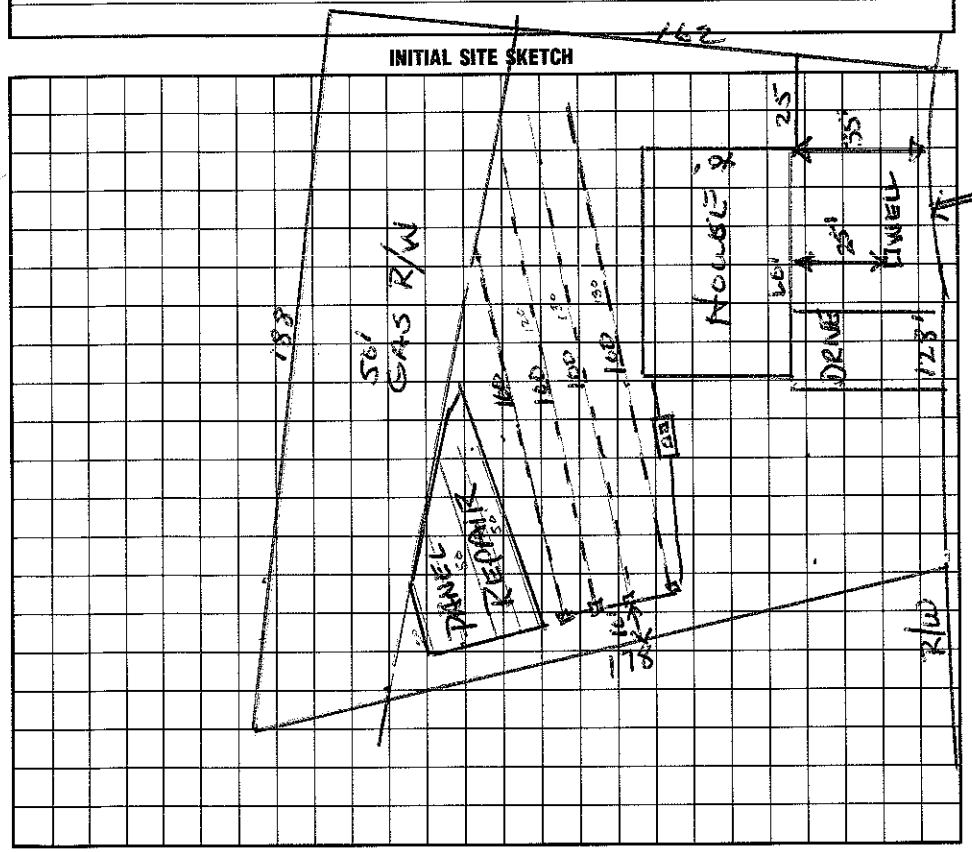

AS BUILT SKETCH

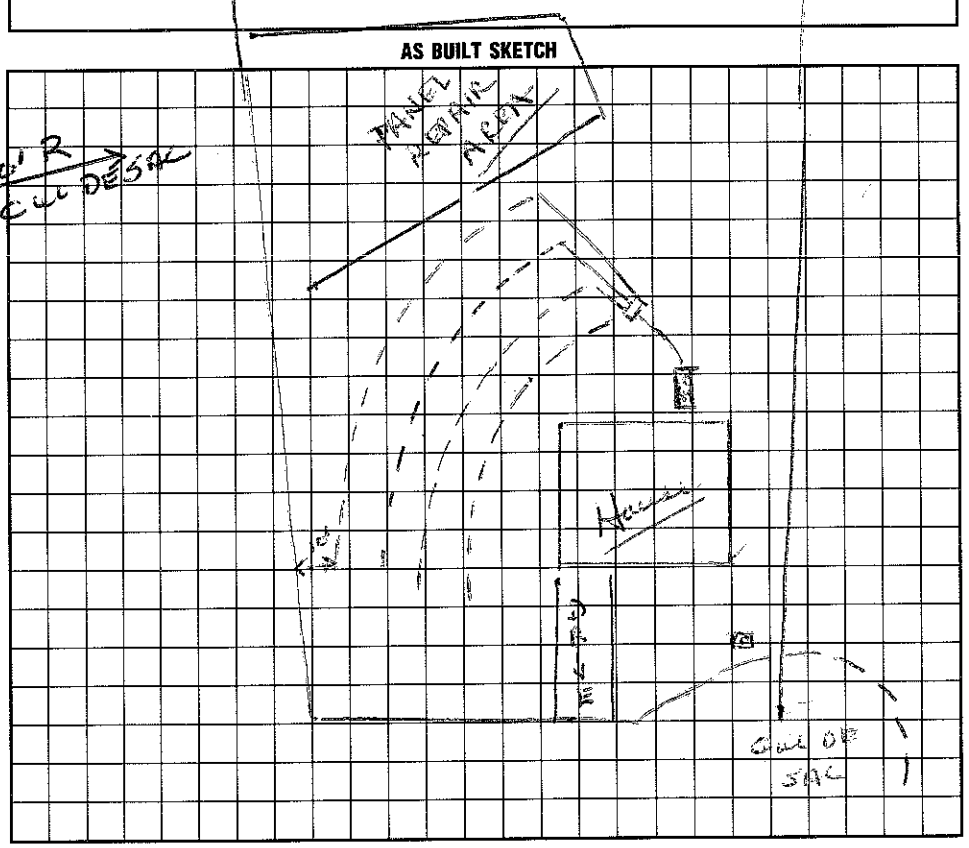

I understand that this permit can be suspended or revoked if any false information is supplied toward securing the permit/any unauthorized changes are made to the site/any unauthorized changes are made in the installation of the system. Improvement Permit is valid for 60 months from date of issuance.

Signed: D. Lee Easter DBA Easter Develop. Corp.

Improvement Permit by: Wesley Sparks RS. date 1/30/95

Existing System Inspection by: date

Installed by: Curt Downing

Certificate of Completion by: date

Operation Permit by: Wesley Sparks RS date 3/11/96

HEALTH DEPT. COPY: WHITE INSPECTION COPY (FINAL): GREEN OWNER COPY (FINAL): YELLOW INSPECTION COPY (INITIAL): PINK OWNER COPY (INITIAL): GOLD