PIN# 4664-47-3099

IREDELL COUNTY HEALTH DEPARTMENT

STATESVILLE 704-878-5305 MOORESVILLE 704-664-5281

IMPROVEMENT PERMIT / CERTIFICATE OF COMPLETION / OPERATION PERMIT / EXISTING SYSTEM INSPECTION

PROPERTY DESCRIPTION NO. 18956 DATE 1/25/95 TAX MAP NO. 1B-A-93 Watershed: ☐ Yes ☑ No

OWNER OR CONTRACTOR Lee Easter Development PHONE: Business 664-2906 Home

ADDRESS 227 Hideaway Ln. Mooresville, NC.

LOCATION Shearers Chapel Rd. on (R) past Presbyterian Rd. (R), 3RD Lot on (L)

SUBDIVISION County Court BLOCK / SECTION 1 LOT 8 LOT AREA 2.69 AC SITE CLASS. P DESIGN FLOW 360 L.T.A.R. .3

Septic Tank: 1000 Gallons; STB 794 Date 6/19/91

Pump Tank: Gallons; PT Date

Pump Make: Model Serial No.

Nitrification Field: No Fields 1 Square Feet 1200 Linear Feet 400

No Lines 4 Trench Width 36" Max Trench Bottom Depth 36" Gravel Depth 12"

☑ New System ☐ Repair System Type: I, II, III, IV, V, VI

System Description: CONV - DROP BOXES

Repair System Description: 12" PPBS SYSTEM

Maintenance Agreement Required: ☐ Yes ☑ No

☑ House/Mod. Home ☐ Mobile Home ☐ Business ☐ Other

No. Bedrooms 3 No. Bathrooms 2 No. Employees


☐ Slab ☐ Crawl Space ☑ Basement w/plumbing ☐ Basement wo/plumbing

Water Supply: ☑ Individual ☐ Community ☐ Public

Comments: S/T COULD BE LOCATED OFF OPPOSITE REAR CORNER - GAS R/W MUST BE CLEARLY MARKED.

Comments:

INITIAL SITE SKETCH

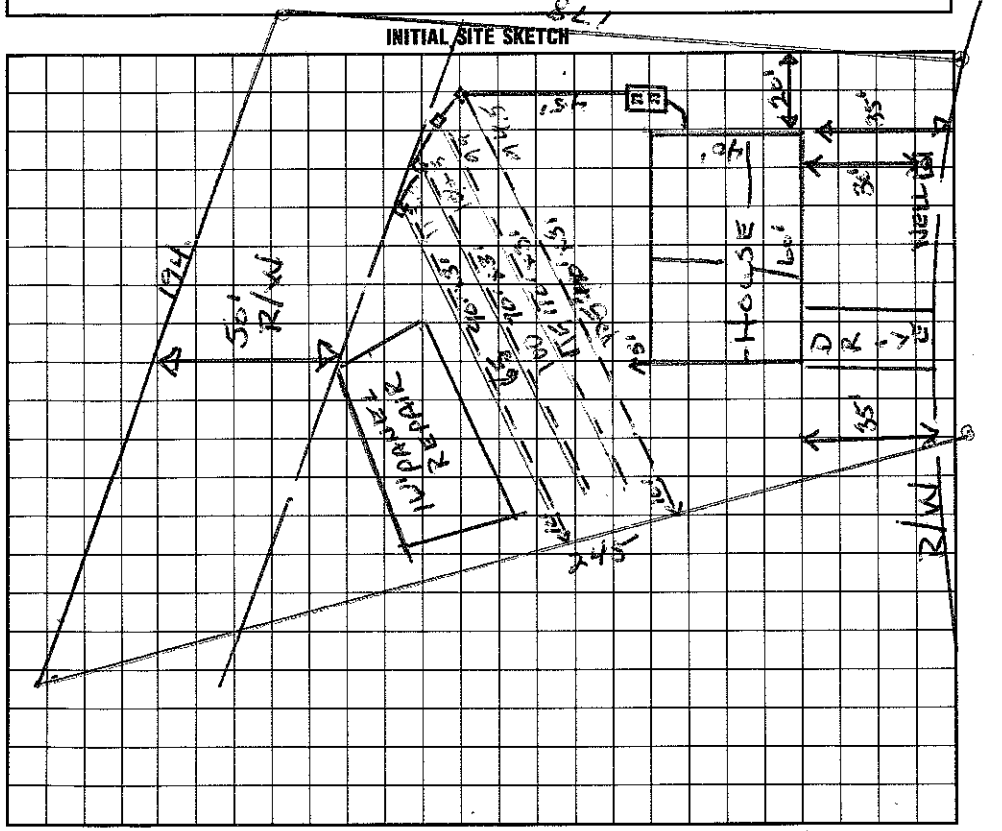

AS BUILT SKETCH

I understand that this permit can be suspended or revoked if any false information is supplied toward securing the permit/any unauthorized changes are made to the site/any unauthorized changes are made in the installation of the system. Improvement Permit is valid for 60 months from date of issuance.

Signed: Lee Easter dba Easter Develop. Corp

Improvement Permit by: Wesley Sparks R.S. date 1/30/95

Existing System Inspection by: date

Installed by: Kirt Dunning

Certificate of Completion by: date

Operation Permit by: C. Brady EHSI date 8/16/96

HEALTH DEPT. COPY: WHITE INSPECTION COPY (FINAL): GREEN OWNER COPY (FINAL): YELLOW INSPECTION COPY (INITIAL): PINK OWNER COPY (INITIAL): GOLD