PIN# 4664-47-3373

IREDELL COUNTY HEALTH DEPARTMENT

STATESVILLE 704-878-5305 MOORESVILLE 704-664-5281

IMPROVEMENT PERMIT / CERTIFICATE OF COMPLETION / OPERATION PERMIT / EXISTING SYSTEM INSPECTION

PROPERTY DESCRIPTION NO. 18951 DATE 1/29/95 TAX MAP NO. 1B - A - 93 Pt of. Watershed: ☐ Yes ☑ No

OWNER OR CONTRACTOR Lee Easter Development PHONE: Business 664-2906 Home

ADDRESS 227 Hideaway Ln. Mooresville, NC.

LOCATION Shearers Chapel Rd (R) past Presbyterian (R) to 3rd lot on (R)

SUBDIVISION Country Court BLOCK / SECTION 1 LOT 3 LOT AREA ~1.62 AC SITE CLASS. P DESIGN FLOW 360 L.T.A.R. .3

Septic Tank: 1000 Gallons; STB 794 Date 5/29/96
Pump Tank: Gallons; PT Date
Pump Make: Model Serial No.
Nitrification Field; No Fields 1 Square Feet 1200 Linear Feet 400
No Lines 4 Trench Width 36" Max Trench Bottom Depth 32" Gravel Depth 12"

☑ New System ☐ Repair System Type: I, (II), III, IV, V, VI
System Description: DIST BOX - CONVENTIONAL
Repair System Description: SAME
Maintenance Agreement Required: ☐ Yes ☑ No


☑ House/Mod. Home No. Bedrooms 3
☐ Mobile Home No. Bathrooms 2
☐ Business No. Employees
☐ Other
☐ Slab ☑ Crawl Space ☐ Basement w/plumbing ☐ Basement wo/plumbing

Water Supply:
☑ Individual
☐ Community
☐ Public

Comments:

Comments:

INITIAL SITE SKETCH

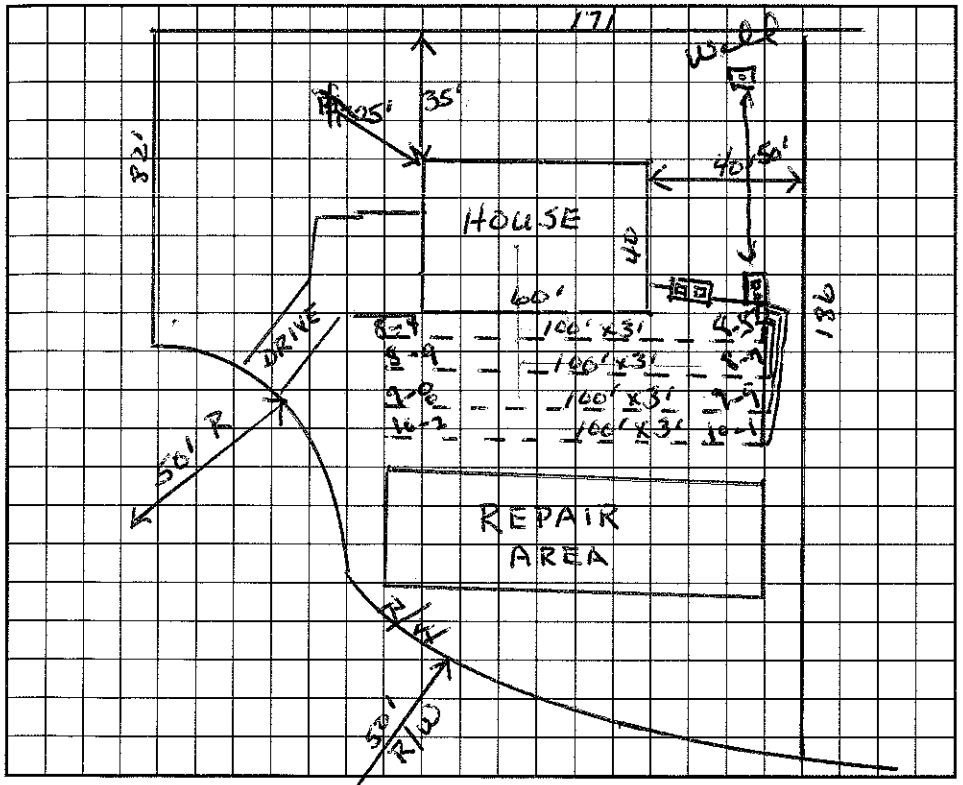

AS BUILT SKETCH

I understand that this permit can be suspended or revoked if any false information is supplied toward securing the permit/any unauthorized changes are made to the site/any unauthorized changes are made in the installation of the system. Improvement Permit is valid for 60 months from date of issuance.

Signed: D Lee Easter DBA Easter Development Co-op Installed by: Curt Dunning

Improvement Permit by: Wesley Sparks RS. date 1/30/95 Certificate of Completion by: date

Existing System Inspection by: date Operation Permit by: Wesley Sparks RS. date 8/7/96

HEALTH DEPT. COPY: WHITE INSPECTION COPY (FINAL): GREEN OWNER COPY (FINAL): YELLOW INSPECTION COPY (INITIAL): PINK OWNER COPY (INITIAL): GOLD