4664-47-5054

IREDELL COUNTY HEALTH DEPARTMENT

STATESVILLE 704-878-5305 MOORESVILLE 704-664-5281

IMPROVEMENT PERMIT / CERTIFICATE OF COMPLETION / OPERATION PERMIT / EXISTING SYSTEM INSPECTION

PROPERTY DESCRIPTION NO. 18959 DATE 1/29/95 TAX MAP NO. 1B-A-93 pt of Watershed: ☐ Yes ☒ No

OWNER OR CONTRACTOR Lee Easter Development PHONE: Business 464-2906 Home

ADDRESS 227 Hideaway Ln. Mooresville, NC.

LOCATION Shearers Chapel Rd, on (R) past Presbyterian Rd., 2nd lot on (L)

SUBDIVISION Country Court BLOCK / SECTION 1 LOT 9 LOT AREA ~ 1.0 Ac SITE CLASS. P DESIGN FLOW 360 L.T.A.R. .25 - 3

Septic Tank: 1000 Gallons; STB 825 Date 3/11/95

Pump Tank: Gallons; PT Date

Pump Make: Model Serial No.

Nitrification Field: No Fields 1 Square Feet 1200 Linear Feet 400

No Lines 5 Trench Width 36" Max Trench Bottom Depth 30" Gravel Depth 12"

☒ New System ☐ Repair System Type: I, (II), III, IV, V, VI

System Description: CONV - DROP 30"

Repair System Description: SAME

Maintenance Agreement Required: ☐ Yes ☒ No

☒ House/Mod. Home No. Bedrooms 3

☐ Mobile Home No. Bathrooms 2

☐ Business No. Employees

☐ Other

☐ Slab ☐ Crawl Space ☒ Basement w/plumbing ☐ Basement wo/plumbing

Water Supply: ☒ Individual ☐ Community ☐ Public


Comments: Well 25' minimum from house foundation, between street and house

Drainage must be controlled to left of trenches


Comments:

5/24/95 Authorized Re-location of S/T and drainfield w/ Lee Easter - Revs.

INITIAL SITE SKETCH

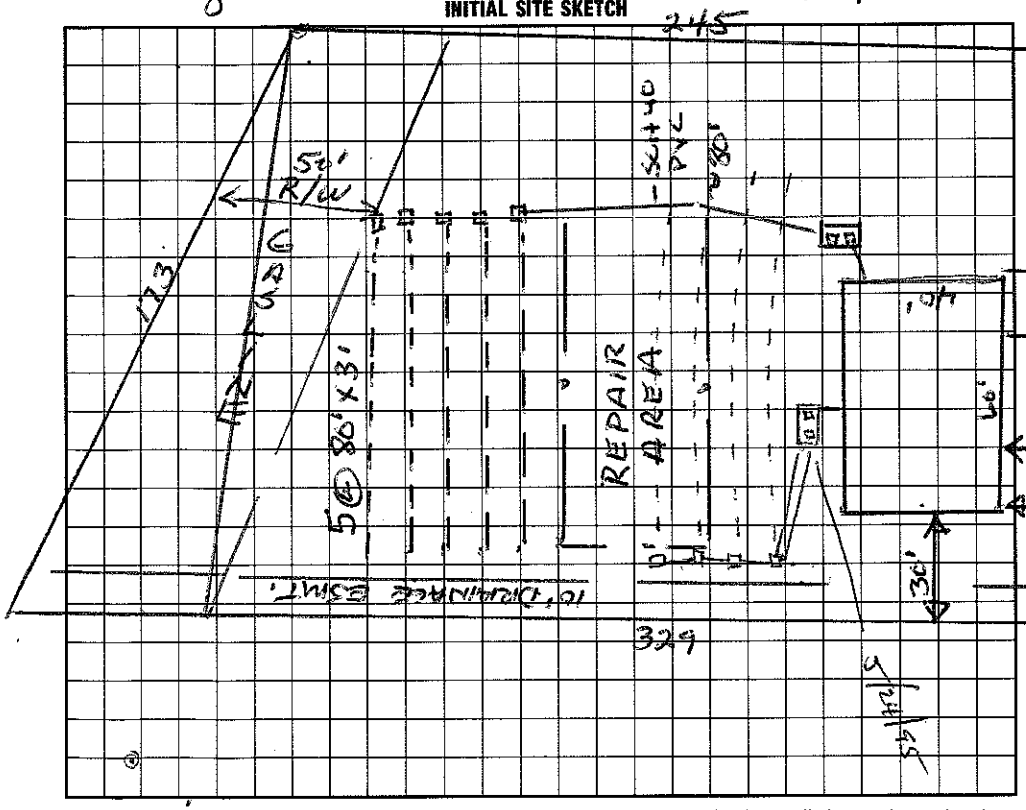

AS BUILT SKETCH

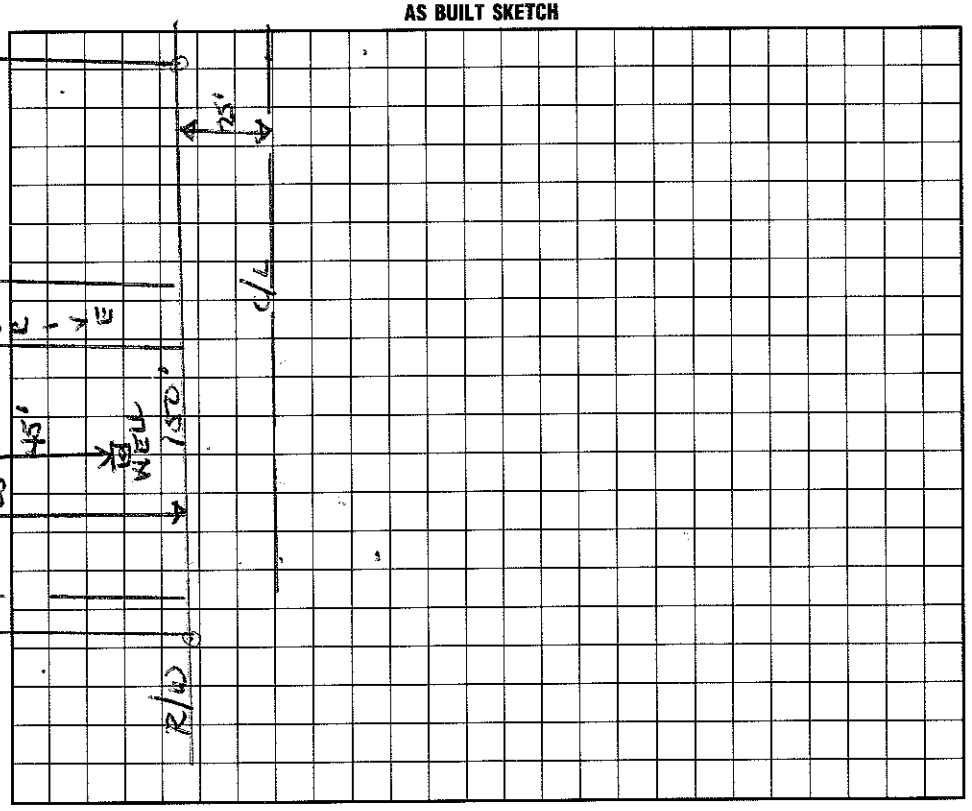

I understand that this permit can be suspended or revoked if any false information is supplied toward securing the permit/any unauthorized changes are made to the site/any unauthorized changes are made in the installation of the system. Improvement Permit is valid for 60 months from date of issuance.

Signed: Lee Easter Dba Easter Develop. Corp

Improvement Permit by: Wesley Sparks R.S. date 1/30/95

Existing System Inspection by: date

Installed by: Curt Dunning

Certificate of Completion by: Wesley Sparks R.S. date 5/31/95

Operation Permit by: date

HEALTH DEPT. COPY: WHITE INSPECTION COPY (FINAL): GREEN OWNER COPY (FINAL): YELLOW INSPECTION COPY (INITIAL): PINK OWNER COPY (INITIAL): GOLD