IREDELL COUNTY HEALTH DEPARTMENT

4664-47-5311

STATESVILLE 704-878-5305 MOORESVILLE 704-664-5281

2pm+

IMPROVEMENT PERMIT / CERTIFICATE OF COMPLETION / OPERATION PERMIT / EXISTING SYSTEM INSPECTION

PROPERTY DESCRIPTION NO. 1895 DATE 1/30/95 TAX MAP NO. 63-01-B-0-A-93 Watershed: ☐ Yes ☐ No

OWNER OR CONTRACTOR Lee Easter Development PHONE: Business 664-2906 Home

ADDRESS 227 Hideaway Ln Mooresville, NC.

LOCATION Antiques Chapel on (R) past Presbyterian (R) 1st second lot on (L)

SUBDIVISION Country Cement BLOCK / SECTION 1 LOT 12 LOT AREA .51 AC SITE CLASS. P DESIGN FLOW 360 L.T.A.R. .3

Septic Tank: 1000 Gallons; STB S25R81 Date 4-21-95

Pump Tank: Gallons; PT Date

Pump Make: Model Serial No.

Nitrification Field: No Fields 1 Square Feet 1200 Linear Feet 400

No Lines 5 Trench Width 36" Max Trench Bottom Depth 30" Gravel Depth 12"

☑ New System ☐ Repair System Type: I (II) III, IV, V, VI

System Description: CONVENTIONAL

Repair System Description: SAME

Maintenance Agreement Required: ☐ Yes ☑ No

☑ House/Mod. Home No. Bedrooms 3

☐ Mobile Home No. Bathrooms 2

☐ Business No. Employees

☐ Other


☐ Slab ☑ Crawl Space ☐ Basement w/plumbing ☐ Basement wo/plumbing

Water Supply: ☑ Individual ☐ Community ☐ Public


Comments:

Comments:

INITIAL SITE SKETCH

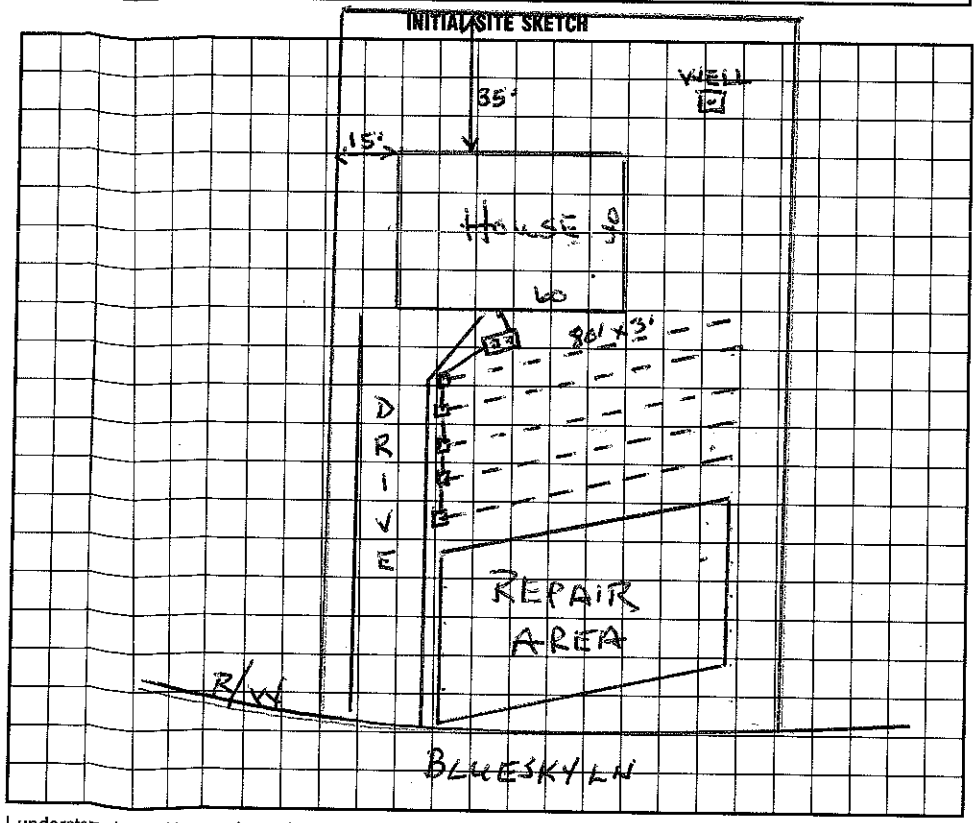

AS BUILT SKETCH

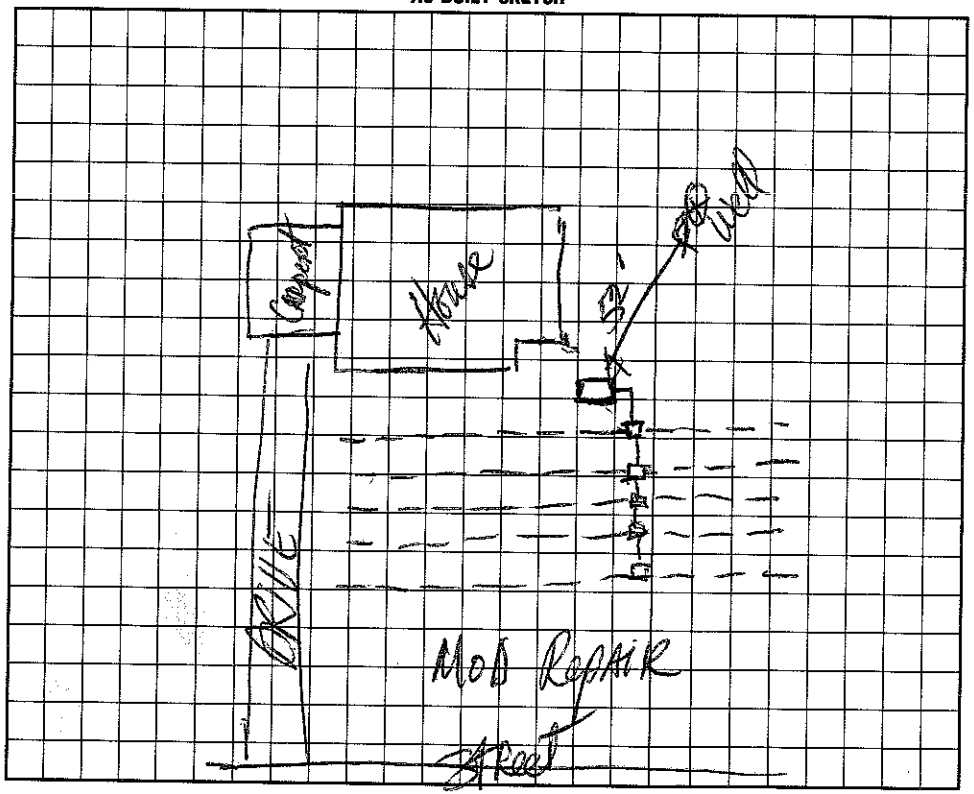

I understand that this permit can be suspended or revoked if any false information is supplied toward securing the permit/any unauthorized changes are made to the site/any unauthorized changes are made in the installation of the system. Improvement Permit is valid for 60 months from date of issuance.

Signed: Lee Easter DBA Easter Development Corp

Improvement Permit by: Wesley Sparks R.S. date 1/30/95

Existing System Inspection by: date

Installed by: Curt Lampman

Certificate of Completion by: date 7-14-95

Operation Permit by: date

HEALTH DEPT. COPY: WHITE INSPECTION COPY (FINAL): GREEN OWNER COPY (FINAL): YELLOW INSPECTION COPY (INITIAL): PINK OWNER COPY (INITIAL): GOLD