4664-47-6061

IREDELL COUNTY HEALTH DEPARTMENT

STATESVILLE 704-878-5305 MOORESVILLE 704-664-5281

IMPROVEMENT PERMIT / CERTIFICATE OF COMPLETION / OPERATION PERMIT / EXISTING SYSTEM INSPECTION

PROPERTY DESCRIPTION NO. 18958 DATE 1/29/95 TAX MAP NO. 1B-A-93 Pt. Watershed: ☐ Yes ☑ No

OWNER OR CONTRACTOR Lee Easter Development PHONE: Business 664-2906 Home

ADDRESS 227 Hideaway Dr. Mooresville

LOCATION Shearers Chapel Rd. on (R) just Past Presbyterian Rd, 1st lot on (L)

SUBDIVISION County Court BLOCK / SECTION 1 LOT 10 LOT AREA ± .91 AC SITE CLASS. P DESIGN FLOW 360 L.T.A.R. .3

Septic Tank: 1000 Gallons; STB 994 Date 3/1/94
Pump Tank: Gallons; PT Date
Pump Make: Model Serial No.
Nitrification Field: No Fields 1 Square Feet 1200 Linear Feet 400
No Lines 6 4 Trench Width 36" Max Trench Bottom Depth 32" Gravel Depth 12"

☑ New System ☐ Repair System Type: I (II) III, IV, V, VI
System Description: DIST BOX - CONVENTIONAL
Repair System Description:
Maintenance Agreement Required: ☐ Yes ☑ No


☑ House/Mod. Home No. Bedrooms 3
☐ Mobile Home No. Bathrooms 2
☐ Business No. Employees
☐ Other
☐ Slab ☑ Crawl Space ☐ Basement w/plumbing ☐ Basement wo/plumbing

Water Supply:
☑ Individual
☐ Community
☐ Public


Comments:

Comments:

INITIAL SITE SKETCH

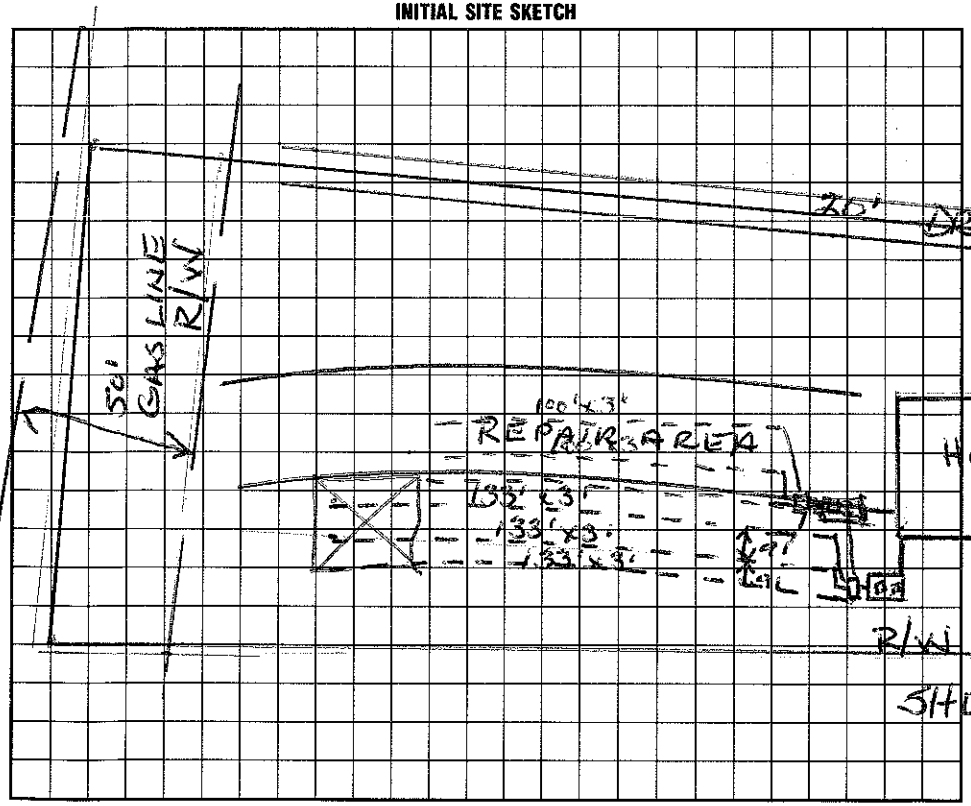

AS BUILT SKETCH

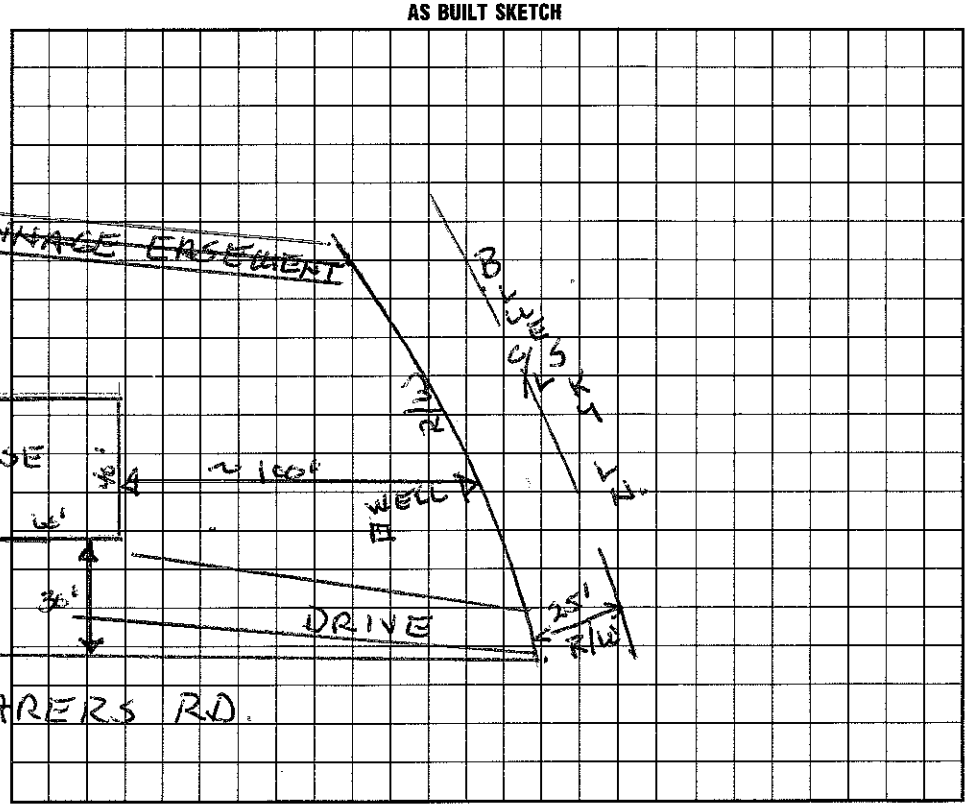

I understand that this permit can be suspended or revoked if any false information is supplied toward securing the permit/any unauthorized changes are made to the site/any unauthorized changes are made in the installation of the system. Improvement Permit is valid for 60 months from date of issuance.

Signed: Lee Easter DBA Easter Devel-Corp Installed by: Curtis Dunning

Improvement Permit by: Wesley Sparks RS. date 1/30/95 Certificate of Completion by: Wesley Sparks RS date 4/28/95

Existing System Inspection by: date Operation Permit by: date

HEALTH DEPT. COPY: WHITE INSPECTION COPY (FINAL): GREEN OWNER COPY (FINAL): YELLOW INSPECTION COPY (INITIAL): PINK OWNER COPY (INITIAL): GOLD