PN# 4664-47-6330

IREDELL COUNTY HEALTH DEPARTMENT

STATESVILLE 704-878-5305 MOORESVILLE 704-664-5281

IMPROVEMENT PERMIT / CERTIFICATE OF COMPLETION / OPERATION PERMIT / EXISTING SYSTEM INSPECTION

PROPERTY DESCRIPTION NO. 18949 DATE 1/30/95 TAX MAP NO. 13-A-93 Pt of Watershed: ☐ Yes ☐ No

OWNER OR CONTRACTOR Lee Easter Development PHONE: Business Home

ADDRESS 227 Hideaway Ln. Mooresville, NC. 28115

LOCATION Theories Chapel Rd. (R) past Presbyterian Rd. (R) to 1st lot on (R)

SUBDIVISION Countryfair BLOCK / SECTION 1 LOT 1 LOT AREA ~1.52AC SITE CLASS. P DESIGN FLOW 360 L.T.A.R. .3

Septic Tank: 1000 Gallons; STB 825 Date 7/8/96

Pump Tank: Gallons; PT Date

Pump Make: Model Serial No.

Nitrification Field: No Fields 1 Square Feet 1200 Linear Feet 400

No Lines 4 Trench Width 36" Max Trench Bottom Depth 32" Gravel Depth 12"

☑ New System ☐ Repair System Type: I, II, III, IV, V, VI

System Description: CONV - DROP BOX

Repair System Description: SAME

Maintenance Agreement Required: ☐ Yes ☑ No

☑ House/Mod. Home No. Bedrooms 3

☐ Mobile Home No. Bathrooms 2

☐ Business No. Employees

☐ Other


☐ Slab ☐ Crawl Space ☐ Basement w/plumbing ☐ Basement wo/plumbing

Water Supply: ☑ Individual ☐ Community ☐ Public

Comments:

Comments: DRIVE NOT LOCATED AT TIME OF INSPECTION.

INITIAL SITE SKETCH

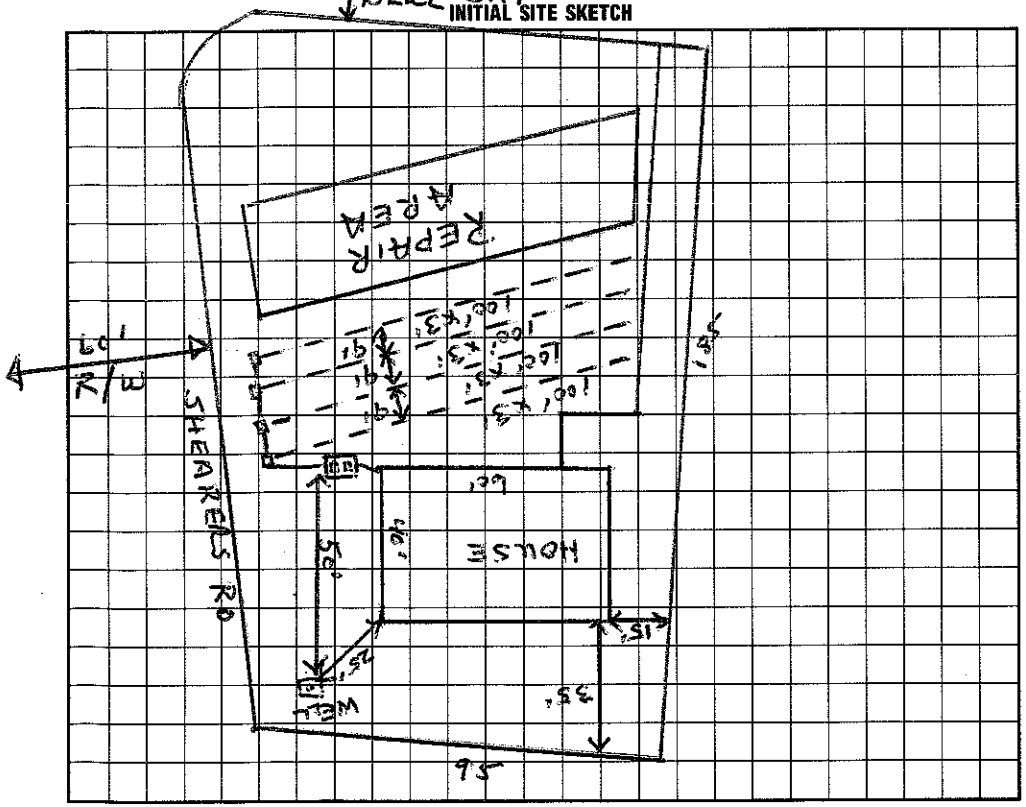

AS BUILT SKETCH

Given as drive site sketch

I understand that this permit can be suspended or revoked if any false information is supplied toward securing the permit/any unauthorized changes are made to the site/any unauthorized changes are made in the installation of the system. Improvement Permit is valid for 60 months from date of issuance.

Signed: Lee Easter OBO Easter Develop. Co.

Improvement Permit by: Wesley Sparks RS date 1/30/95

Existing System Inspection by: date

Installed by: CERT OWNER

Certificate of Completion by: date

Operation Permit by: C. Barkstrom EHSI date 10/30/96

HEALTH DEPT. COPY: WHITE INSPECTION COPY (FINAL): GREEN OWNER COPY (FINAL): YELLOW INSPECTION COPY (INITIAL): PINK OWNER COPY (INITIAL): GOLD