IREDELL COUNTY HEALTH DEPARTMENT

Statesville Office (704) 878-5305 Mooresville Office (704) 660-3625 PERMIT # 210969

IMPROVEMENT PERMIT / AUTHORIZATION TO CONSTRUCT / OPERATION PERMIT / EXISTING SYSTEM

PIN # 4664-48-5770-000 1628

APPLICANT: Freedom Haynes APPLICANT ADDRESS: 1042 Charlotte Hwy Troutman NC

SITE ADDRESS: 1628 Shearers Rd. Davidson NC PHONE: 704-578-7960 ALT. PHONE:

SITE DIRECTIONS: Sugaree Rd S from Mooresville, Site on R.

SUBDIVISION: N/A SECTION: — LOT # — LOT AREA: 1.641 Acre DESIGN FLOW: 360 GPD L.T.A.R.: .25

Septic Tank EXISTING (gal) STB Date

Pump Tank (gal) PT Date

Pump Make Model Serial #

Nitrification Fields 1 # Lines 2@60' Linear Ft: 120'

Trench Width 36" Max. Trench Bottom Depth * 22" * Gravel Depth N/A

☐ New System ☐ Repair ☒ Expansion System Type: I II III IV V VI

System Description: 25% REDUCTION - GRAVITY

Repair System Description: 25% REDUCTION - PUMP

Maintenance Agreement Required: ☐ YES ☒ NO

☑ GRAVITY ☐ PRESSURE

☑ Residence No. Bedrooms 3

☐ Business No. Persons 6

☐ Other No. Employees


☐ Slab ☒ Crawl Space

☐ Basement w/plumbing ☐ Basement w/o plumbing

Water Supply: ☒ Private ☐ Public ☐ Community

Comments / Conditions: 3 BDRM DISTRIBUTE EXISTING SYSTEM TO 2 NEW 60' (2) FOOT LINES. TO EXPAND SYSTEM TO 3 BR. CHECK EXISTING DISTRIBUTION. MAINTAIN 5' SEPERATION FROM SEPTIC WITH NEW MOBILE HOME AND 25' SEPERATION FROM WELL.

INITIAL SITE SKETCH

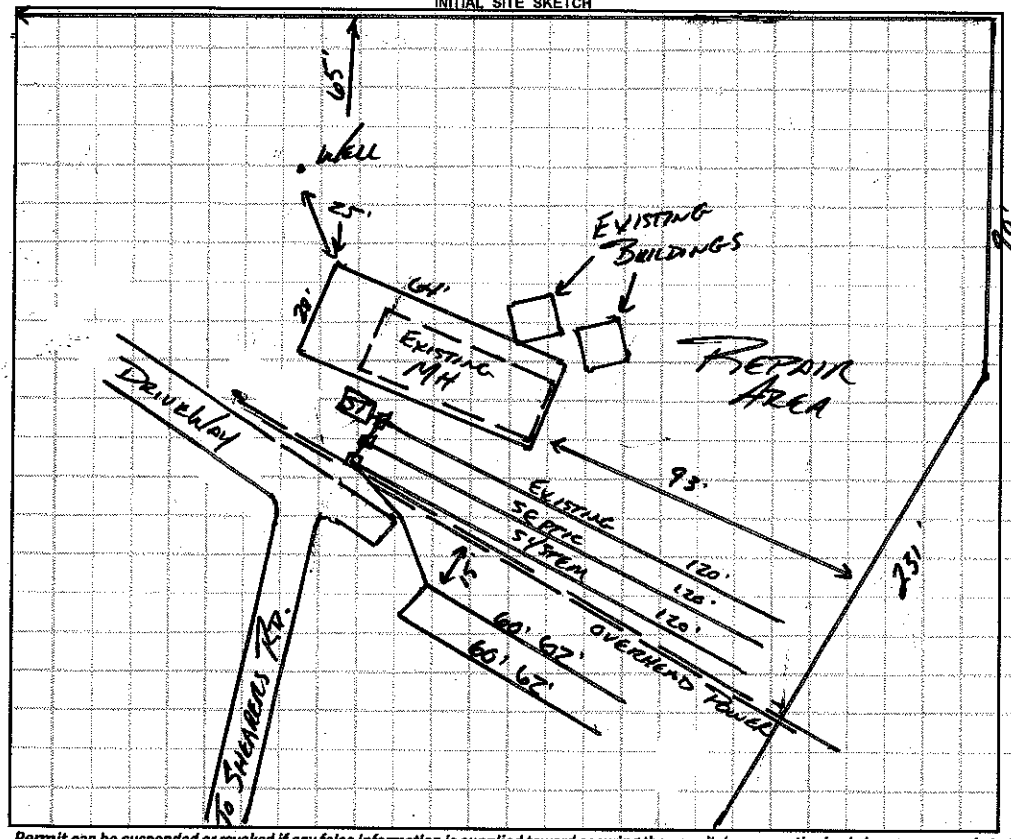

AS BUILT SKETCH

Permit can be suspended or revoked if any false information is supplied toward securing the permit / any unauthorized changes are made to the site / any unauthorized changes are made in the installation of the system. **CONTACT A LOCATOR SERVICE PRIOR TO ANY EXCAVATION**

☐ **IMPROVEMENT PERMIT** *with plat valid without expiration.* ☑ **IMPROVEMENT PERMIT** *with site plan valid for 60 mos.* ☑ **AUTHORIZATION TO CONSTRUCT** *valid for period equal to IMPROVEMENT PERMIT--not to exceed 60 mo.*

Owner / Applicant Signature: Date: 9-2-15

Installed by: CRAIG THOMPSON

IMPROVEMENT PERMIT by: APPROVED AUG 21 2015

AUTHORIZATION TO CONSTRUCT by: APPROVED Date: AUG 21 2015

OPERATION PERMIT by: Date: 9-30-15

Existing System Inspected by: Date:

Health Dept. Copy - WHITE Applicant (Final Approval) - YELLOW Applicant (Conditional Approval) - PINK