(4.00)

IREDELL COUNTY HEALTH DEPARTMENT

STATESVILLE 704-878-5305 MOORESVILLE 704-664-5281

IMPROVEMENT PERMIT / CERTIFICATE OF COMPLETION / OPERATION PERMIT / EXISTING SYSTEM INSPECTION

PROPERTY DESCRIPTION NO. 066770 DATE 5/27/97 TAX MAP NO. 4664488852 Watershed: ☑ Yes ☐ No

OWNER OR CONTRACTOR RUSSELL, HARRY PHONE: Business _____ Home 478 - 5238

ADDRESS 7931 MOCCASIN DR.

LOCATION SHEARERS RD - ON LT CORNER OF SHEARERS AND VILLA LN.

SUBDIVISION BELLE GLADE BLOCK / SECTION - LOT 1 LOT AREA ~1¼ AC SITE CLASS. PS DESIGN FLOW 360GPD L.T.A.R. .80 , .35 GPD/FT²

Septic Tank: 1000 Gallons; STB 794 Date 12/9/97

Pump Tank: _____ Gallons; PT _____ Date _____

Pump Make: _____ Model _____ Serial No. _____

Nitrification Field: No Fields 1 Square Feet 750 Linear Feet 260

No Lines 6 Trench Width 36" Max Trench Bottom Depth 36" Gravel Depth N/A

☑ New System ☐ Repair System Type: I, II, III, IV, V, VI

System Description: GRAVITY CHAMBERED OR SEMI-C

Repair System Description: PUMP PANEL

Maintenance Agreement Required: ☐ Yes ☑ No

☑ House/Mod. Home No. Bedrooms 3

☐ Mobile Home No. Bathrooms 2

☐ Business No. Employees _____

☐ Other _____


☐ Slab ☑ Crawl Space ☐ Basement w/plumbing ☐ Basement wo/plumbing

Water Supply: ☐ Individual ☑ Community ☐ Public


Comments: 2 44 5 ~~250~~

Comments: 2 44 ~~250~~ 260 10 25 35

INITIAL SITE SKETCH

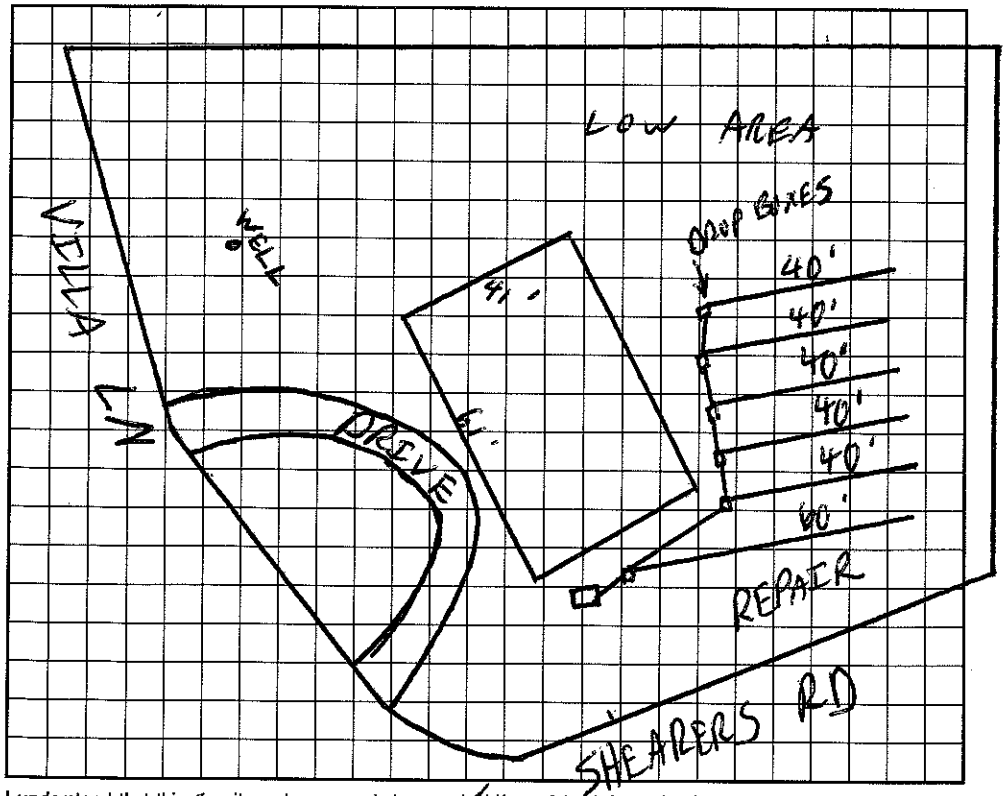

AS BUILT SKETCH

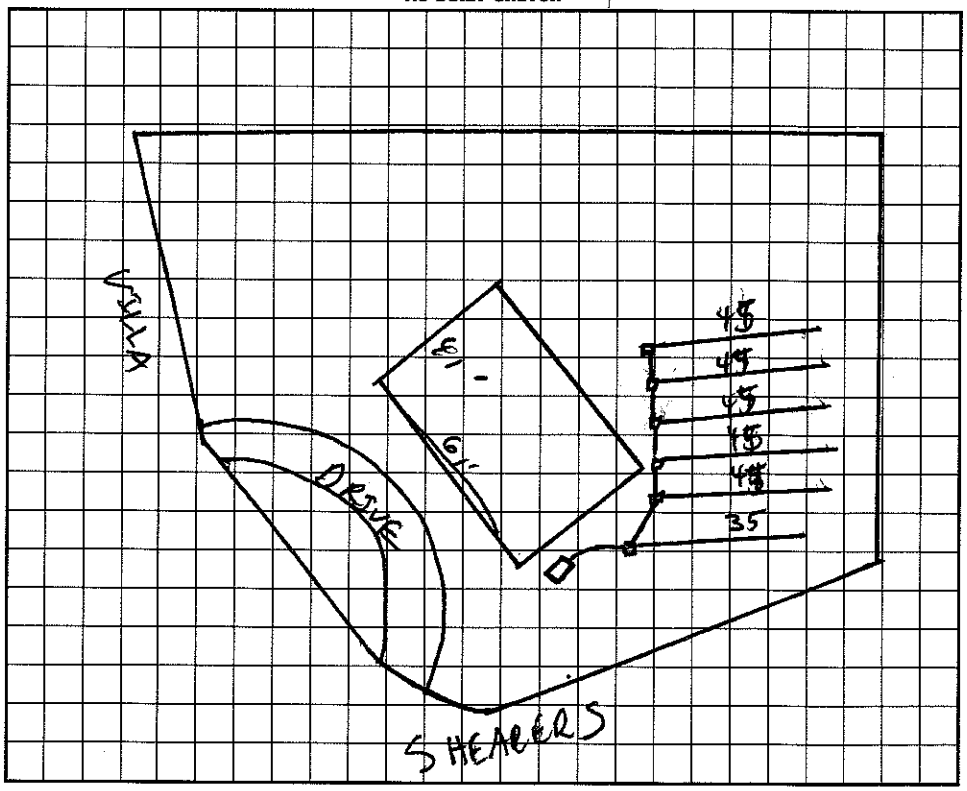

I understand that this permit can be suspended or revoked if any false information is supplied toward securing the permit/any unauthorized changes are made to the site/any unauthorized changes are made in the installation of the system. Improvement Permit is valid for 60 months from date of issuance.

Signed: Harry Russell

Improvement Permit by: C. Ray Zeamer date 5/27/97

Existing System Inspection by: C. Ray Zeamer date 5/27/97

Installed by: DWIGHT AVERY GRADING

Certificate of Completion by: _____ date _____

Operation Permit by: C. Ray Zeamer RS date 2/10/98

HEALTH DEPT. COPY: WHITE INSPECTION COPY (FINAL): GREEN OWNER COPY (FINAL): YELLOW INSPECTION COPY (INITIAL): PINK OWNER COPY (INITIAL): GOLD