IREDELL COUNTY HEALTH DEPARTMENT - *ENVIRONMENTAL HEALTH* ☐ STATESVILLE OFFICE 704-878-5305 ☒ MOORESVILLE OFFICE 704-664-5281

IMPROVEMENT PERMIT / AUTHORIZATION TO CONSTRUCT / OPERATION PERMIT / EXISTING SYSTEM INSPECTION

PERMIT # 171288 PIN # 4664-48-9757 ✓ DATE 4-17-12

OWNER TERRY MEIER APPLICANT: SAME PHONE: Home/Cell # 704-896-8763 Business #

SITE ADDRESS 117 VILLA LN; Davidson OWNER / APPLICANT ADDRESS SAME

SITE DIRECTIONS SHEARERS, TL VILLA, ON R

SUBDIVISION BELLE GLADE BLOCK / SECTION LOT # 2 LOT AREA .497AC DESIGN FLOW 360 L.T.A.R. .3

Septic Tank Ex. 1000 Gallons: STB Date

Pump Tank Gallons: P T Date

Pump Make Model Serial #

No. Nitrification Fields: 1 No. Lines 1 Linear Feet 80'

Trench Width 36" Max. Trench Bottom Depth 36" Gravel Depth 12"

☐ New System ☐ Repair ☐ Expansion System Type I ☒ II III IV V VI

System Description: GRAVITY CONVENTIONAL

Repair System Description: GRAVITY 25%

Maintenance Agreement Required ☐ YES ☒ NO

☒ GRAVITY ☐ PRESSURE

☒ Residence No. Bedrooms 3

☐ Business No. Persons

☒ Other No. Employees

☐ Slab ☒ Crawl Space

☐ Basement w/plumbing ☐ Basement w/o plumbing

Water Supply

☒ Private


☐ Public

☐ Community


Comments / Conditions ① ADD 1-80' LINE & ABANDON TOP LINE ② MAY USE 25% RED.

ADDITION

INITIAL SITE SKETCH

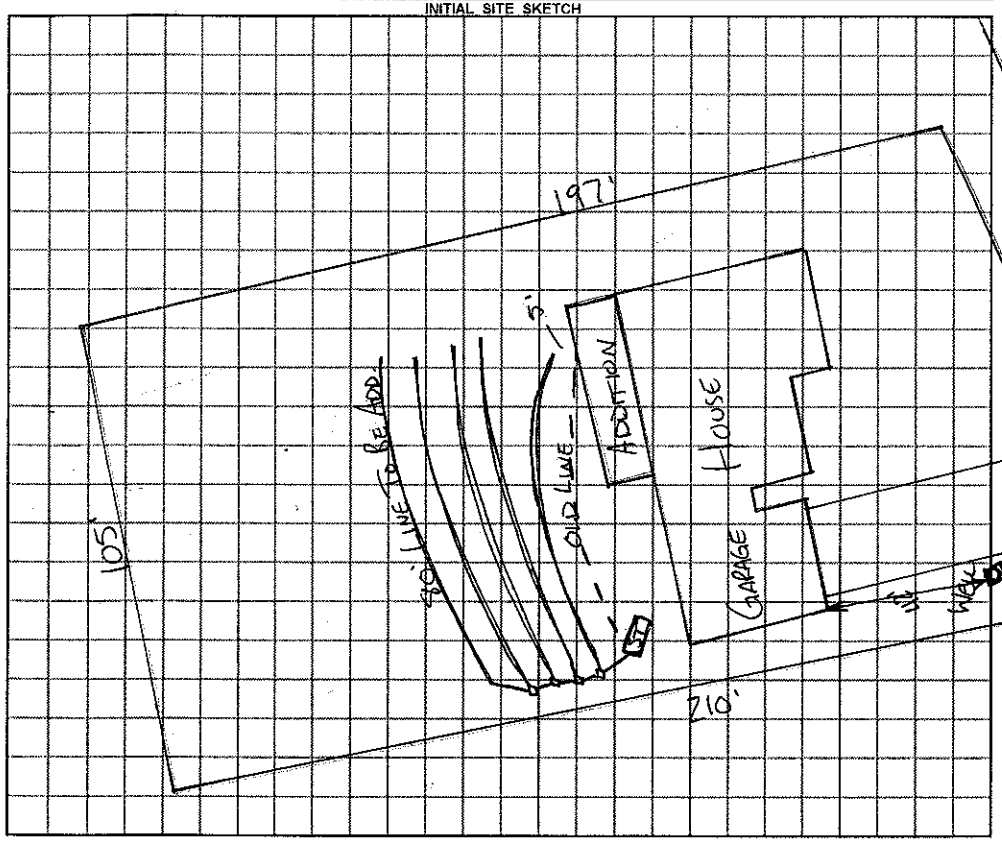

AS BUILT SKETCH

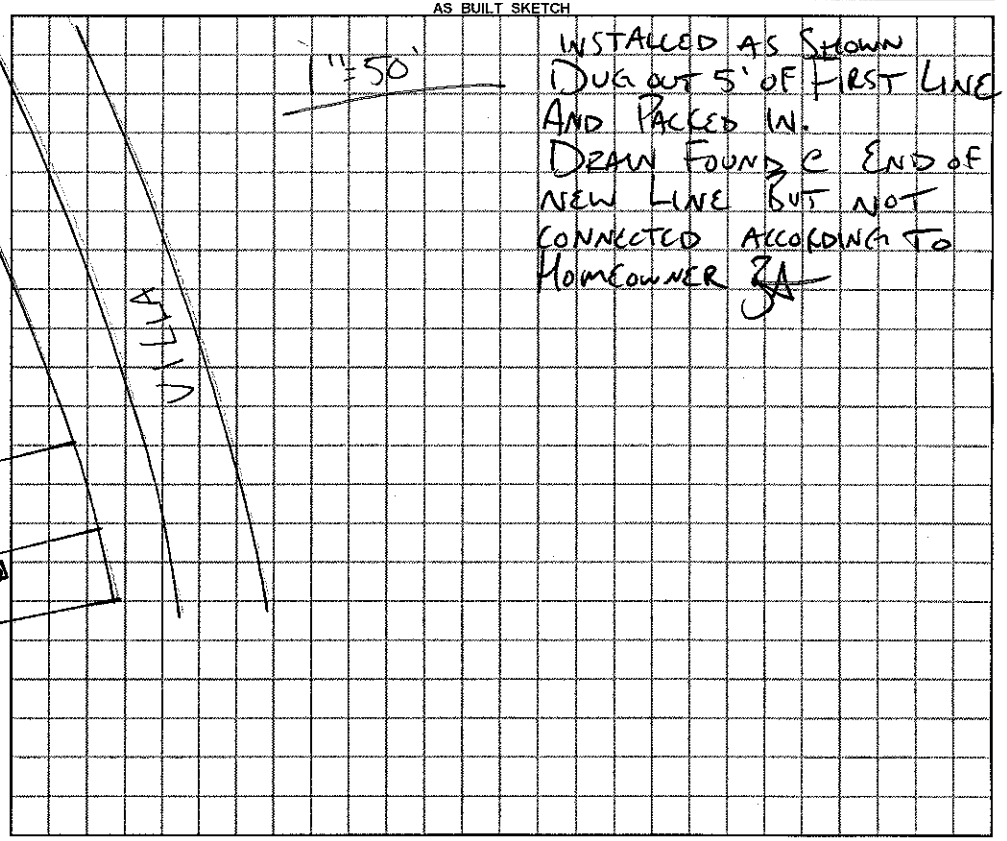

Permit can be suspended or revoked if any false information is supplied toward securing the permit / any unauthorized changes are made to the site / any unauthorized changes are made in the installation of the system.

☐ ***IMPROVEMENT PERMIT*** with plat valid without expiration. ☐ ***IMPROVEMENT PERMIT*** with plat valid without expiration. site plan valid 60 mo. ☐ ***AUTHORIZATION TO CONSTRUCT*** valid for period equal to IMPROVEMENT PERMIT--not to exceed 60 mo.

Owner / Applicant Signature: Date 4/27/12 Installed by:

IMPROVEMENT PERMIT by: REHS Date 4-17-12 OPERATION PERMIT by: REHS Date 10-21-16

AUTHORIZATION TO CONSTRUCT by: REHS Date 4-17-12 Existing System Inspected by: REHS Date

YOU SHOULD CONTACT A LOCATOR SERVICE PRIOR TO ANY EXCAVATION

White Copy – Environmental Health YELLOW COPY (Final) Owner / Applicant PINK COPY (Initial) Owner / Applicant