IREDELL COUNTY HEALTH DEPARTMENT

STATESVILLE 704-878-5305 MOORESVILLE 704-664-5281

IMPROVEMENT PERMIT / AUTHORIZATION TO CONSTRUCT / OPERATION PERMIT / EXISTING SYSTEM INSPECTION

PERMIT# 12594 PIN# ~~4665 30 2395.003~~ 4664-49-2363 DATE 1/11/05

OWNER OR CONTRACTOR HUNTINGTON GLOBE LLC / MONOGRAM HOMES PHONE: Business _____ Home _____

ADDRESS 255 ROLLING HILLS RD MOORESVILLE

LOCATION SHEARERS RD - TR PRESBYTERIAN RD - ON RT

SUBDIVISION HUNTINGTON RIDGE BLOCK / SECTION 1 LOT 3 LOT AREA .705 SITE CLASS 05 DESIGN FLOW ~~460~~ 360 L.T.A.R. .256 RD/FT²

Septic Tank: 1000 Gallons; STB 794 Date 3-30-07
Pump Tank: _____ Gallons; PT _____ Date _____
Pump Make: _____ Model _____ Serial No. _____
Nitrification Field: No Fields 1 Square Feet 480 Linear Feet 240
No Lines 6@40' Trench Width 24" Max Trench Bottom Depth 36" Gravel Depth N/A

☑ New System ☐ Repair System Type: I, II, III, IV, V, VI
System Description: GRAVITY PANEL
Repair System Description: LP PANEL
Maintenance Agreement Required: ☐ Yes ☑ No

☑ House/Mod. Home No. Bedrooms 3
☐ Mobile Home No. Bathrooms 3
☐ Business No. Employees ____
☐ Other _____


☐ Slab ☑ Crawl Space ☐ Basement w/plumbing ☐ Basement wo/plumbing

Water Supply: ☑ Individual ☐ Public ☐ Community


Comments:/Conditions:

Comments:/Conditions:

INITIAL SITE SKETCH 1"=50'

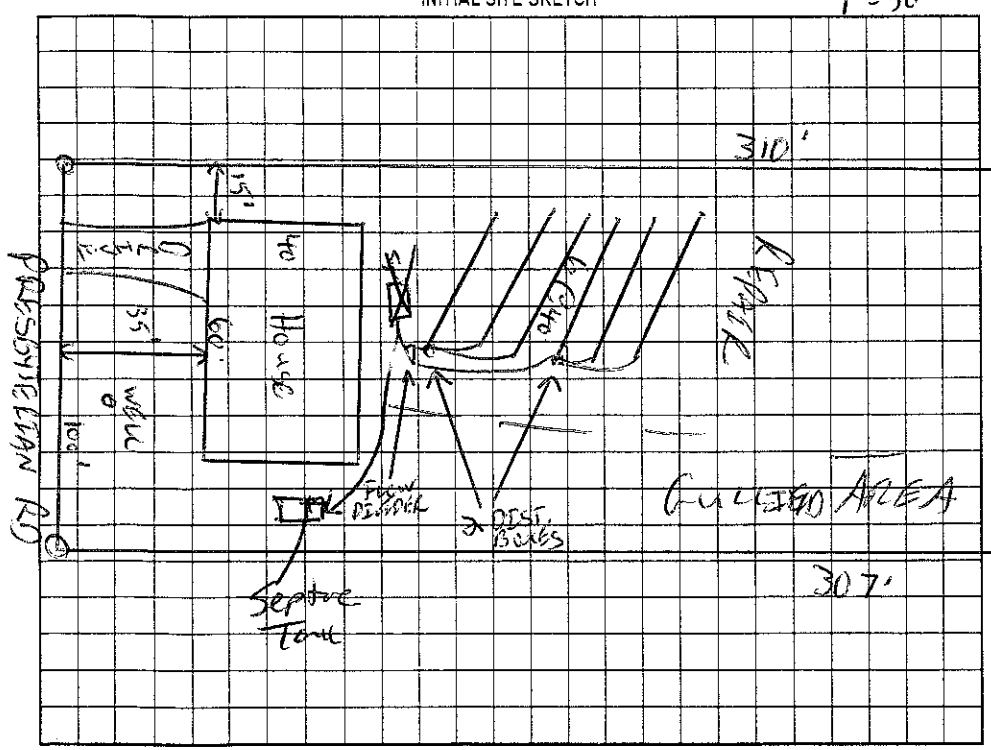

AS BUILT SKETCH

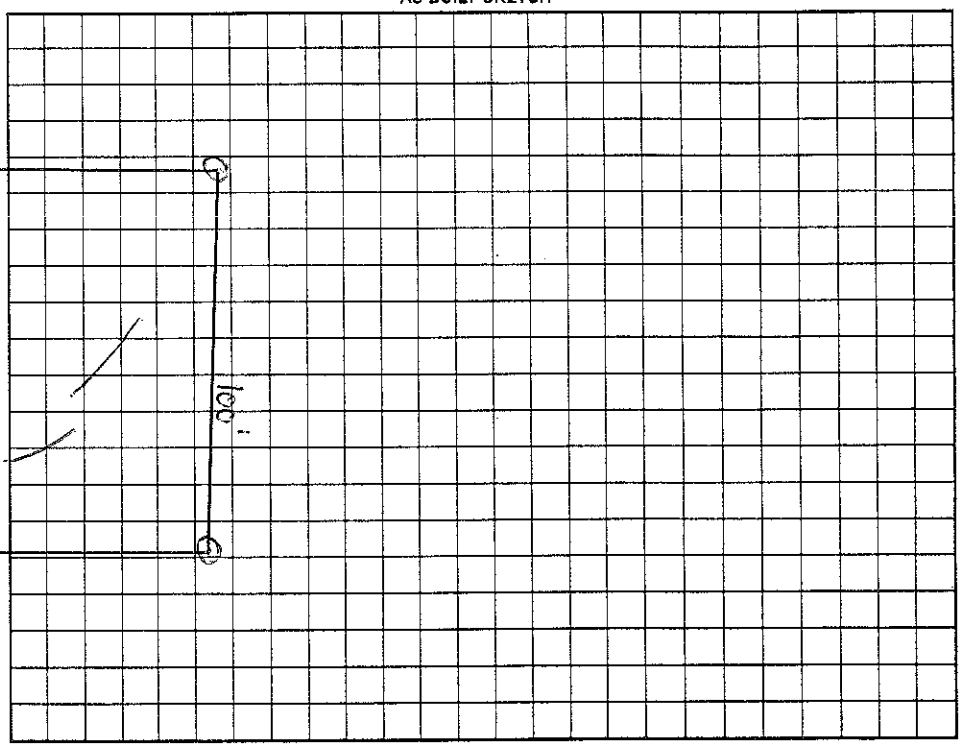

Permit can be suspended or revoked if any false information is supplied toward securing the permit/any unauthorized changes are made to the site/any unauthorized changes are made in the installation of the system. Improvement Permit with plat valid without expiration. Improvement Permit with ~~site plan valid~~ for sixty months. Authorization to Construct is valid for a period equal to that of Improvement Permit – not to exceed sixty months.

Signed: Karen E McNair date 1/11/05 Installed by: Dellinger

Improvement Permit by: [signature] date 1/11/05 Operation Permit by: John E Aycock date 5-23-07

Authorization to Construct by: John E Aycock date 4-19-07 Existing System Inspection by: _____ date _____

HEALTH DEPT. COPY: WHITE OWNER COPY (FINAL): YELLOW OWNER COPY (INITIAL): PINK