IREDELL COUNTY HEALTH DEPARTMENT

STATESVILLE 704-878-5305 MOORESVILLE 704-664-5281

IMPROVEMENT PERMIT / AUTHORIZATION TO CONSTRUCT / OPERATION PERMIT / EXISTING SYSTEM INSPECTION

PERMIT# 122602 PIN# 4665 30 3395 04 4664-49-2617 DATE 1/11/05

OWNER OR CONTRACTOR HUNTINGTON RIDGE LLC / Duane Plummer PHONE: Business _____ Home _____

ADDRESS 255 COLLEGE HILLS RD MOORESVILLE 28117

LOCATION SHEARERS RD - TR HUNTINGTON RIDGE - ON LT

SUBDIVISION HUNTINGTON RIDGE BLOCK / SECTION 1 LOT 11 LOT AREA 1.252ac SITE CLASS. PS DESIGN FLOW 480GPD L.T.A.R. - 360GPD

Septic Tank: 1000 Gallons; STB 1007 Date 12/12/05

Pump Tank: _____ Gallons; PT _____ Date _____

Pump Make: _____ Model _____ Serial No. _____

Nitrification Field: No Fields 2 Square Feet 1440 Linear Feet 480

No Lines 6@50' Trench Width 36" Max Trench Bottom Depth 30" Gravel Depth #57

☑ New System ☐ Repair System Type: I II III IV V VI

System Description: GRAVITY 2 SYSTEM CONVENTIONAL

Repair System Description: LP FORM

Maintenance Agreement Required: ☐ Yes ☑ No

☑ House/Mod. Home No. Bedrooms 7

☐ Mobile Home No. Bathrooms 4

☐ Business No. Employees _____

☐ Other _____


☐ Slab ☑ Crawl Space ☐ Basement w/plumbing ☐ Basement wo/plumbing

Water Supply: ☑ Individual ☐ Public ☐ Community


Comments:/Conditions:

Comments:/Conditions:

INITIAL SITE SKETCH 1" = 50'

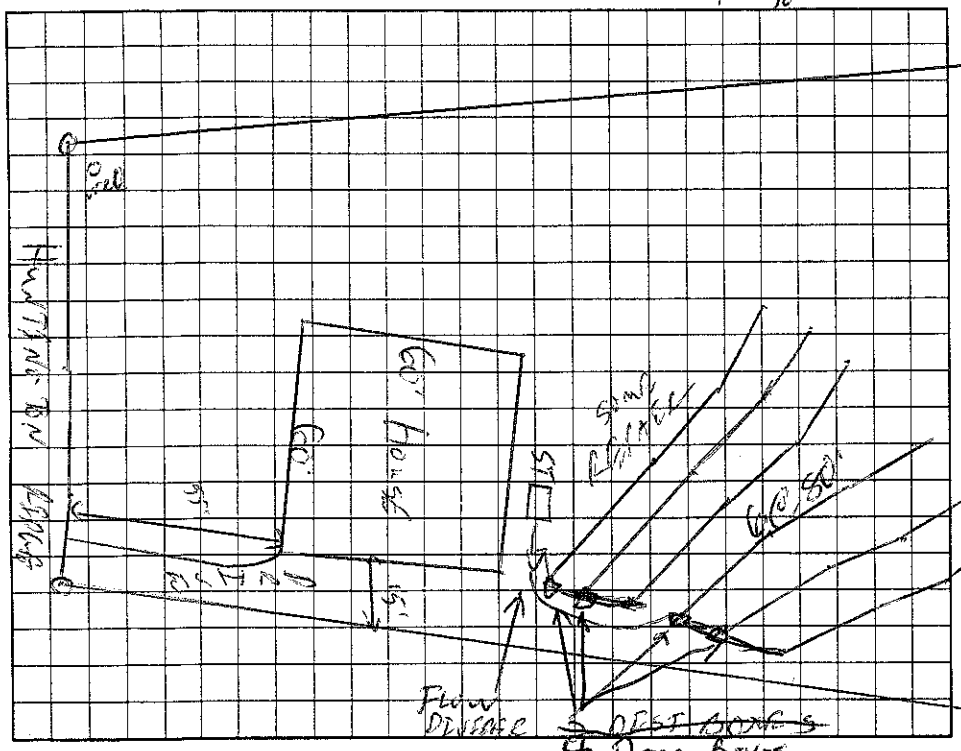

AS BUILT SKETCH

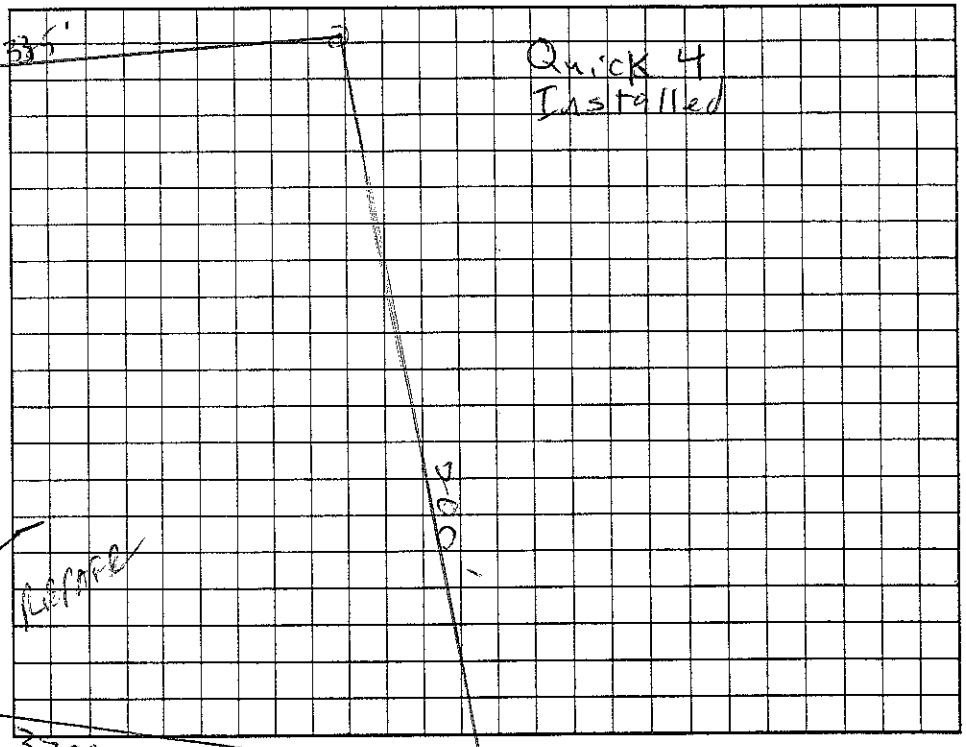

Permit can be suspended or revoked if any false information is supplied toward securing the permit/any unauthorized changes are made to the site/any unauthorized changes are made in the installation of the system. Improvement Permit with plat valid without expiration. Improvement Permit with site plan valid for sixty months. Authorization to Construct is valid for a period equal to that of Improvement Permit – not to exceed sixty months.

Signed: _____ date 1/11/05

Improvement Permit by: _____ date 1/11/05

Authorization to Construct by: _____ date 8/29/05

Installed by: Richard Abernathy

Operation Permit by: _____ date 2/16/06

Existing System Inspection by: _____ date _____

HEALTH DEPT. COPY: WHITE OWNER COPY (FINAL): YELLOW OWNER COPY (INITIAL): PINK