IREDELL COUNTY HEALTH DEPARTMENT

STATESVILLE 704-878-5305 MOORESVILLE 704-664-5281

2:30

IMPROVEMENT PERMIT / AUTHORIZATION TO CONSTRUCT / OPERATION PERMIT / EXISTING SYSTEM INSPECTION

PERMIT# 12601 PIN# ~~4665 30 3395 00~~ 4664-49-3763 DATE 1/11/05

OWNER OR CONTRACTOR Huntington Ridge LLC / Michael Jones PHONE: Business Home

ADDRESS 255 Rolling Hills Rd Mooresville NC 28117

LOCATION Shearers Rd - TR Huntington Ridge - 2nd on LT

SUBDIVISION Huntington Ridge BLOCK / SECTION LOT 10 LOT AREA .866AC SITE CLASS. CS DESIGN FLOW 450GPD L.T.A.R. CS .360/KS

Septic Tank: 1000 Gallons; STB 794 Date 7-22-05

Pump Tank: 1000 Gallons; PT 283 Date 6-17-07

Pump Make: Goulds Model PE5IM Serial No.

Nitrification Field: No Fields 1 Square Feet 540 Linear Feet 270

No Lines 5@54" Trench Width 24" Max Trench Bottom Depth 32" Gravel Depth

☒ New System ☐ Repair System Type: I, II, III, IV, V, VI

System Description: LPP BANKS

Repair System Description: SAME

Maintenance Agreement Required: ☒ Yes ☐ No

☒ House/Mod. Home No. Bedrooms 4

☐ Mobile Home No. Bathrooms 4

☐ Business No. Employees

☐ Other


☐ Slab ☒ Crawl Space ☐ Basement w/plumbing ☐ Basement wo/plumbing

Water Supply: ☒ Individual ☐ Public ☐ Community


Comments:/Conditions:

Comments/Conditions: 8/21/07 5/32" hole drilled Checked tanks, lines & pressure 9/26/07 Electrical Sheehan

INITIAL SITE SKETCH 1" = 50'

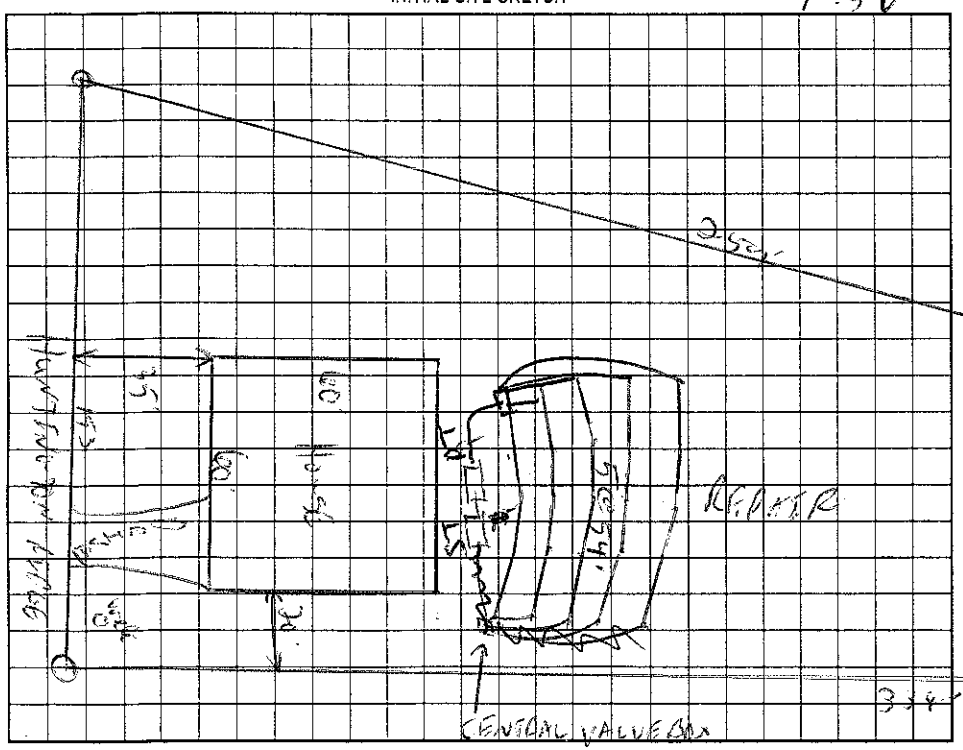

AS BUILT SKETCH

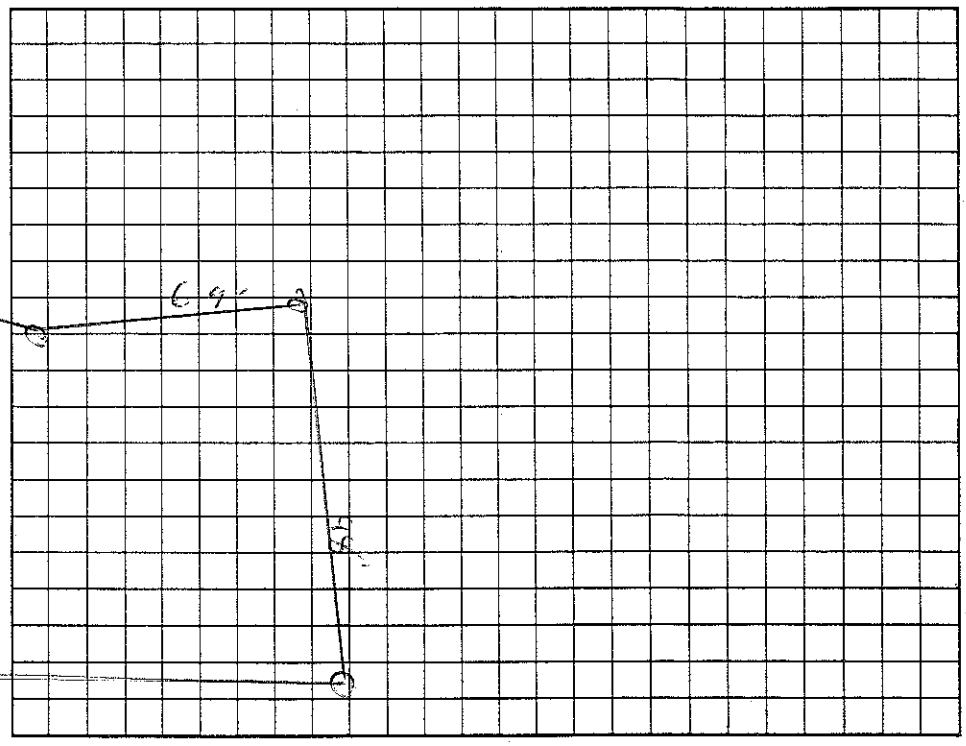

Permit can be suspended or revoked if any false information is supplied toward securing the permit/any unauthorized changes are made to the site/any unauthorized changes are made in the installation of the system. Improvement Permit with plat valid without expiration. Improvement Permit with site plan valid for sixty months. Authorization to Construct is valid for a period equal to that of Improvement Permit – not to exceed sixty months.

Signed: date 1/11/05 Installed by: Richard Hagerathy RS

Improvement Permit by: CS date 1/11/05 Operation Permit by: date 9/27/07

Authorization to Construct by: Wesley Sparks RS date 4/13/06 Existing System Inspection by: date

HEALTH DEPT. COPY: WHITE OWNER COPY (FINAL): YELLOW OWNER COPY (INITIAL): PINK