# IREDELL COUNTY HEALTH DEPARTMENT

STATESVILLE 704-878-5305 130.00 Paid MOORESVILLE 704-664-5281

## IMPROVEMENT PERMIT / AUTHORIZATION TO CONSTRUCT / OPERATION PERMIT / EXISTING SYSTEM INSPECTION

PERMIT# 122600 PIN# 4665-30-3395.009 4664-49-4666 DATE 12/23/04

OWNER OR CONTRACTOR HUNTINGTON RIDGE LLC / BLAIR BUILDER INC PHONE: Business _____ Home _____

ADDRESS 255 ROLLING HILLS RD MOORESVILLE 28117

LOCATION SHARRS RD (SR) - TR HUNTINGTON RIDGE - ON LT

SUBDIVISION HUNTINGTON RIDGE BLOCK / SECTION _____ LOT 9 LOT AREA 1.112AC SITE CLASS. PS DESIGN FLOW 480GPD L.T.A.R. .36 AC/LOT

Septic Tank: 1000 Gallons; STB 1012 Date 3-1-07

Pump Tank: 1000 Gallons; PT PT Date 3-26-07

Pump Make: Goulds Model WE0311N Serial No. _____

Nitrification Field: No Fields 1 Square Feet @ 1200 Linear Feet 400

No Lines 5@80' Trench Width 36" Max Trench Bottom Depth 20" Gravel Depth N/A

☑ New System ☐ Repair System Type: I, II, III, IV, V, VI

System Description: Pump 25% Reduction

Repair System Description: SAME

Maintenance Agreement Required: ☐ Yes ☑ No

☑ House/Mod. Home No. Bedrooms 4

☐ Mobile Home No. Bathrooms 4

☐ Business No. Employees _____

☐ Other _____

☐ Slab ☐ Crawl Space ☑ Basement w/plumbing ☐ Basement wo/plumbing

Water Supply: ☑ Individual ☐ Public ☐ Community

Comments:/Conditions:


Comments:/Conditions:

11/2/07 Installed Quick 4 for Drainfield. Essentially as Drawn


11/2/07 Checked tanks & field

11/5/07 Pressure checked.

INITIAL SITE SKETCH 1"=50'

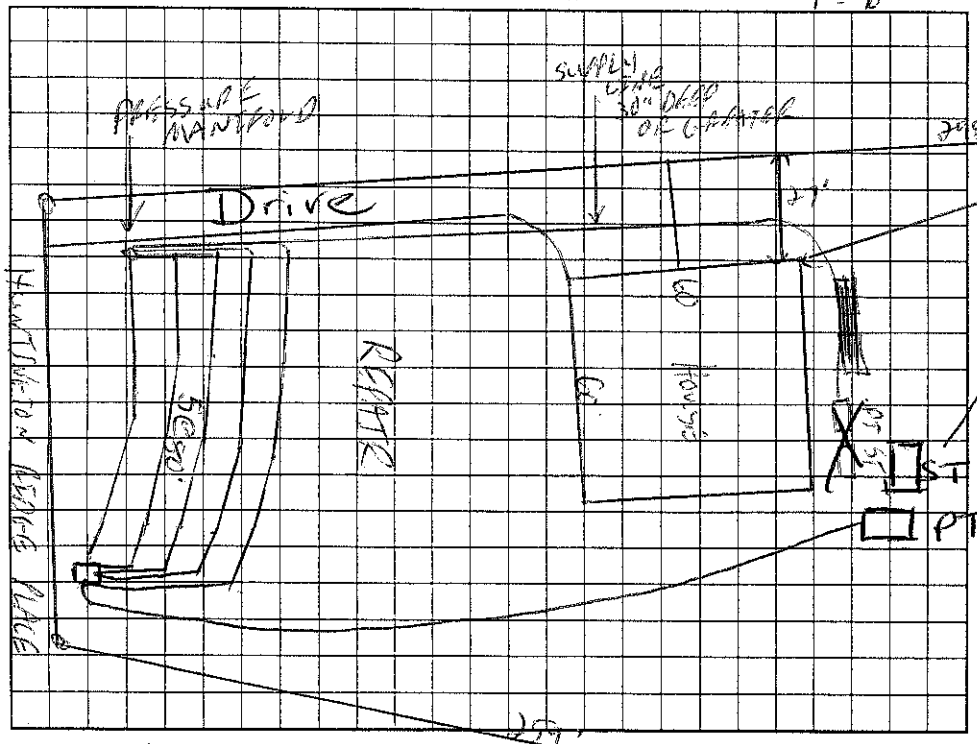


AS BUILT SKETCH

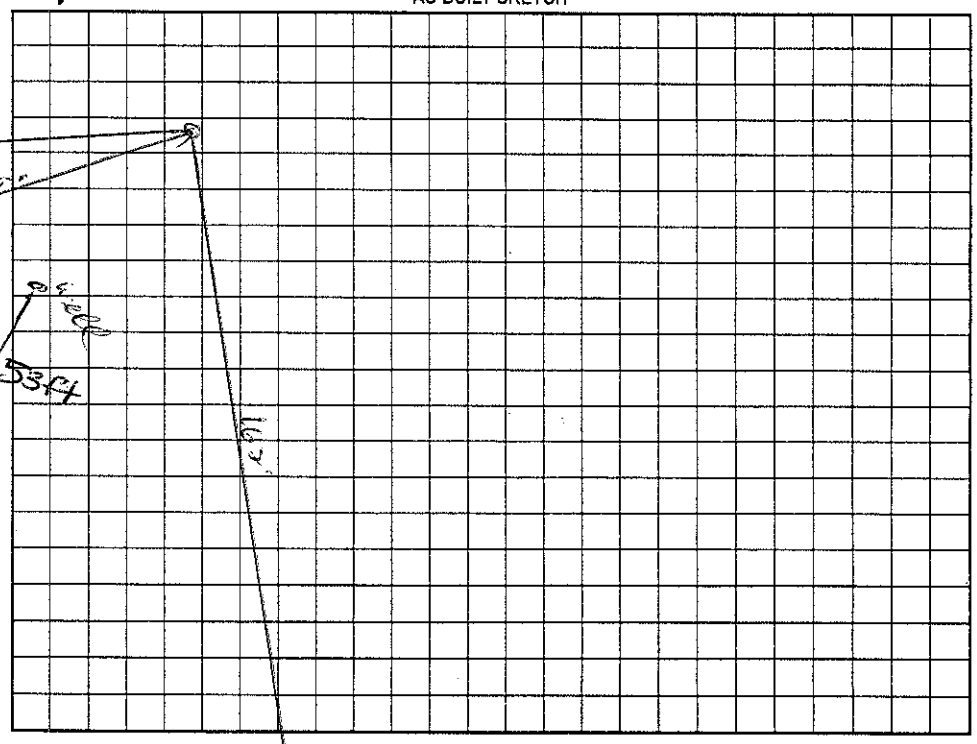


Permit can be suspended or revoked if any false information is supplied toward securing the permit/any unauthorized changes are made to the site/any unauthorized changes are made in the installation of the system. Improvement Permit with plat valid without expiration. Improvement Permit with site plan valid for sixty months. Authorization to Construct is valid for a period equal to that of Improvement ~~Permit~~ not to exceed sixty months.

Signed: _____ date 1/3/05 Installed by: Craig Thompson RS 12/16/07

Improvement Permit by: _____ RS date 12/23/04 Operation Permit by: _____ date _____

Authorization to Construct by: Wesley Sparks RS. date 2/13/07 Existing System Inspection by: _____ date _____

HEALTH DEPT. COPY: WHITE OWNER COPY (FINAL): YELLOW OWNER COPY (INITIAL): PINK