IREDELL COUNTY HEALTH DEPARTMENT

STATESVILLE 704-878-5305 MOORESVILLE 704-664-5281

IMPROVEMENT PERMIT / AUTHORIZATION TO CONSTRUCT / OPERATION PERMIT / EXISTING SYSTEM INSPECTION

PERMIT# 12597 PIN# ~~4665 30 3395.000~~ 4664-49-6359 DATE 1/11/05

OWNER OR CONTRACTOR HUNTINGTON RIDGE LLC PHONE: Business _____ Home _____

ADDRESS 255 ROLLING HILLS RD MOORESVILLE

LOCATION SHEARERS RD - TR PRESBYTERIAN RD - DV RT

SUBDIVISION HUNTINGTON RIDGE BLOCK / SECTION 1 LOT 6 LOT AREA .674 Ac SITE CLASS. PS DESIGN FLOW 450 GPD L.T.A.R. .360/FT²

Septic Tank: 1000 Gallons; STB 794 Date 2/16/06

Pump Tank: _____ Gallons; PT _____ Date _____

Pump Make: _____ Model _____ Serial No. _____

Nitrification Field: No Fields 1 Square Feet 1200 Linear Feet 400

No Lines 6 Trench Width 36" Max Trench Bottom Depth 36" Gravel Depth _____

☑ New System ☐ Repair System Type: I, II, III, IV, V, VI

System Description: GRAVITY 75% REDUCTION

Repair System Description: LP PANEL

Maintenance Agreement Required: ☐ Yes ☐ No

☑ House/Mod. Home No. Bedrooms 4

☐ Mobile Home No. Bathrooms 4

☐ Business No. Employees ____

☐ Other _____


☐ Slab ☑ Crawl Space ☐ Basement w/plumbing ☐ Basement wo/plumbing

Water Supply: ☑ Individual ☐ Public ☐ Community


Comments:/Conditions:

Comments:/Conditions:

INITIAL SITE SKETCH 1" = 50'

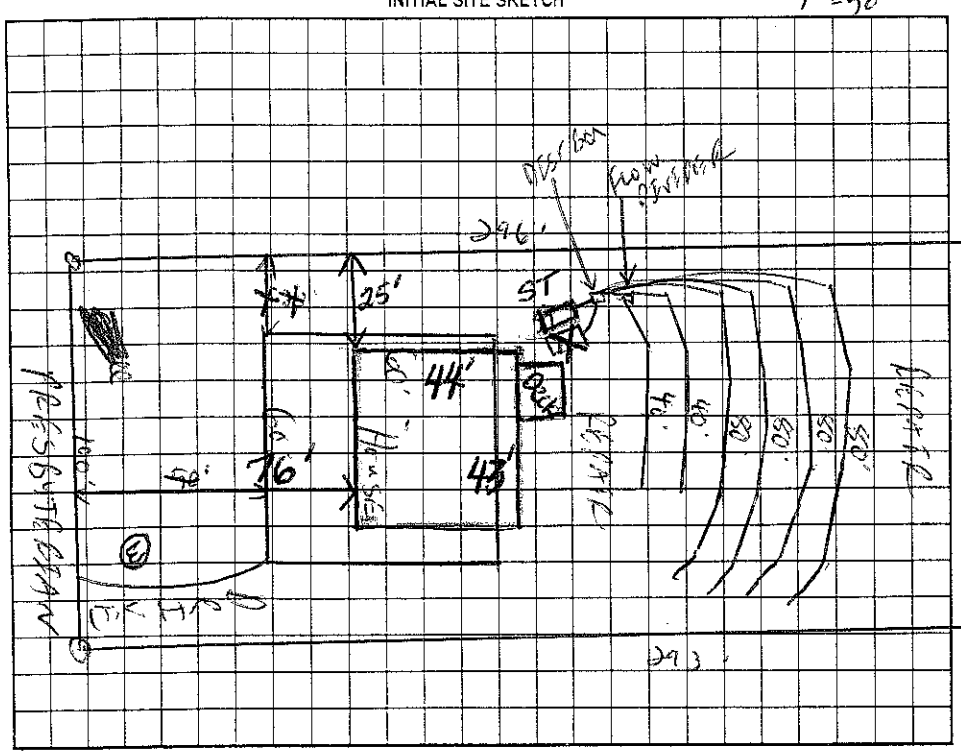

AS BUILT SKETCH

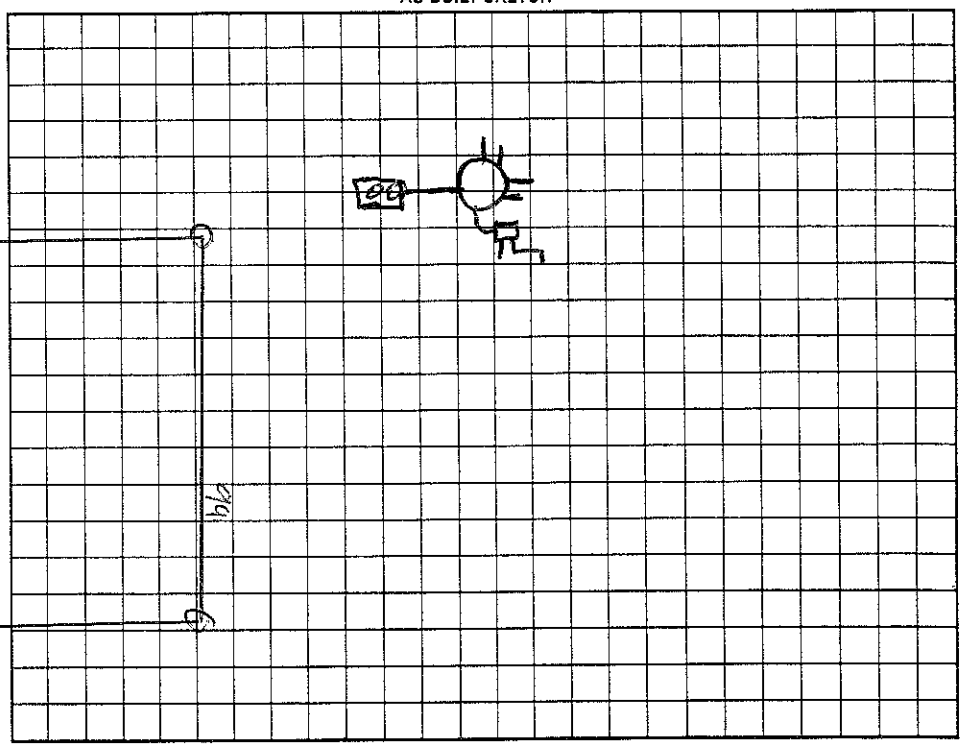

Permit can be suspended or revoked if any false information is supplied toward securing the permit/any unauthorized changes are made to the site/any unauthorized changes are made in the installation of the system. Improvement Permit with plat valid without expiration. Improvement Permit with site plan valid for sixty months. Authorization to Construct is valid for a period equal to that of Improvement Permit – not to exceed sixty months.

Signed: _____ date 1/11/05 Installed by: Hanby Septic Service

Improvement Permit by: C. _____ RS date 1/11/05 Operation Permit by: Wesley Sparks RS. date 4/12/06

Authorization to Construct by: Judy McNeill date 1-9-06 Existing System Inspection by: _____ date _____

HEALTH DEPT. COPY: WHITE OWNER COPY (FINAL): YELLOW OWNER COPY (INITIAL): PINK