IREDELL COUNTY HEALTH DEPARTMENT

STATESVILLE 704-878-5305 MOORESVILLE 704-664-5281

IMPROVEMENT PERMIT / AUTHORIZATION TO CONSTRUCT / OPERATION PERMIT / EXISTING SYSTEM INSPECTION

PERMIT# 122599 PIN# 4665 30 3395.008 4664-49-6741 DATE 1/11/05

OWNER OR CONTRACTOR HUNTINGTON REDOE LLC/GARY SHMITT PHONE: Business Home

ADDRESS 255 RELIANCE ITEMS RD MOORESVILLE NC 28117

LOCATION SHEARERS RD. TR HUNTINGTON REDOE - ON LT CORNER

SUBDIVISION HUNTINGTON REDOE BLOCK / SECTION LOT 6 LOT AREA 1.039AC SITE CLASS. RS DESIGN FLOW 480GPD L.T.A.R. .256gpd/ft2

Septic Tank: 1000 Gallons; STB 312 Date 10/28/05

Pump Tank: 1000 Gallons; PT 283 Date 10/25/05

Pump Make: Model Serial No.

Nitrification Field: No Fields 1 Square Feet 1440 Linear Feet 480

No Lines 6@80' Trench Width 36" Max Trench Bottom Depth 30" Gravel Depth N/A

☑ New System ☐ Repair System Type: I, II, (III) IV, V, VI

System Description: Pump 2HP Reduction

Repair System Description: LP Panel

Maintenance Agreement Required: ☐ Yes ☑ No

☑ House/Mod. Home No. Bedrooms 4

☐ Mobile Home No. Bathrooms 4

☐ Business No. Employees

☐ Other


☐ Slab ☐ Crawl Space ☑ Basement w/plumbing ☐ Basement wo/plumbing

Water Supply: ☑ Individual ☐ Public ☐ Community


Comments:/Conditions:

Comments:/Conditions:

1"=50' INITIAL SITE SKETCH

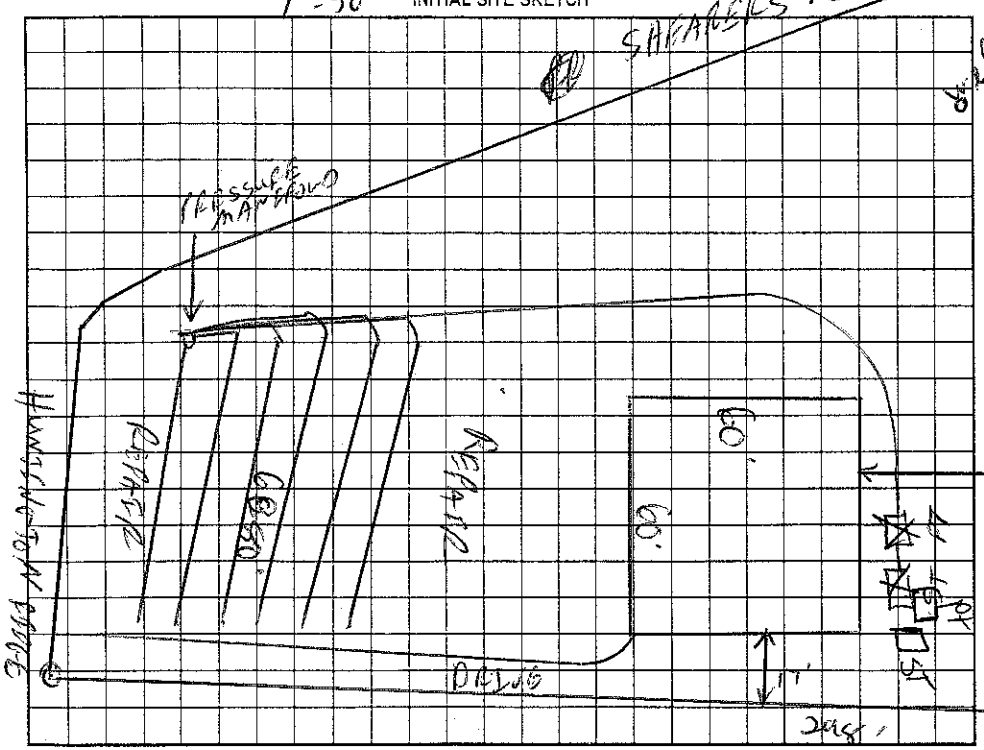

AS BUILT SKETCH

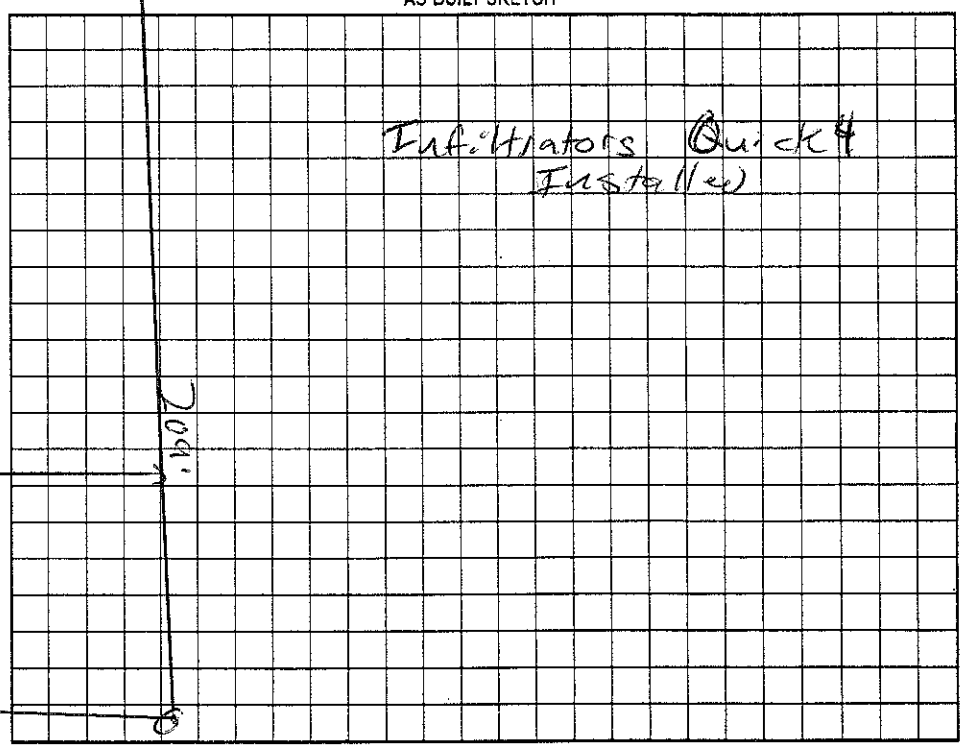

Permit can be suspended or revoked if any false information is supplied toward securing the permit/any unauthorized changes are made to the site/any unauthorized changes are made in the installation of the system. Improvement Permit with plat valid without expiration. Improvement Permit with site plan valid for sixty months. Authorization to Construct is valid for a period equal to that of Improvement Permit – not to exceed sixty months.

Signed: [signature] date 1/11/05 Installed by: Penwaden

Improvement Permit by: [signature] date 1/11/05 Operation Permit by: Wesley Sparks R.S. date 9/20/06

Authorization to Construct by: Wesley Sparks RS date 1/11/05 Existing System Inspection by: date

HEALTH DEPT. COPY: WHITE OWNER COPY (FINAL): YELLOW OWNER COPY (INITIAL): PINK