IREDELL COUNTY HEALTH DEPARTMENT

STATESVILLE 704-878-5305 MOORESVILLE 704-664-5281

AN#4664-49-9601

IMPROVEMENT PERMIT / CERTIFICATE OF COMPLETION / OPERATION PERMIT / EXISTING SYSTEM INSPECTION

PROPERTY DESCRIPTION NO. 20215 DATE 2/3/95 TAX MAP NO. 113-2-A 33 Watershed: ☐ Yes ☑ No

OWNER OR CONTRACTOR Barry C. Lysery PHONE: Business _____ Home 581-9154

ADDRESS PO Box 1524 Davidson, NC. 28115

LOCATION Sherrill Rd. T Lon Villa Ln. (L) corner system

SUBDIVISION Belle Glade BLOCK / SECTION _____ LOT 33 LOT AREA 1.35 Ac. SITE CLASS. P DESIGN FLOW 360 L.T.A.R. .35

Septic Tank: 1250 Gallons; STB 794 Date 7/19/95

Pump Tank: _____ Gallons; PT _____ Date _____

Pump Make: _____ Model _____ Serial No. _____

Nitrification Field: No Fields 1 Square Feet 1025 Linear Feet 360

No Lines 4 Trench Width 36" Max Trench Bottom Depth 30-32" Gravel Depth 12"

☑ New System ☐ Repair System Type: I, (II) III, IV, V, VI

System Description: Conv - Dist Box

Repair System Description: _____

Maintenance Agreement Required: ☐ Yes ☑ No

☑ House/Mod. Home No. Bedrooms 3

☐ Mobile Home No. Bathrooms 2

☐ Business No. Employees _____

☑ Other Drainage Disposal

☐ Slab ☑ Crawl Space ☐ Basement w/plumbing ☐ Basement wo/plumbing


Water Supply: ☑ Individual ☐ Community ☐ Public

Comments:

Lowest part of depression off limits
Tight - call H.D. with questions before beginning work

Comments:

INITIAL SITE SKETCH

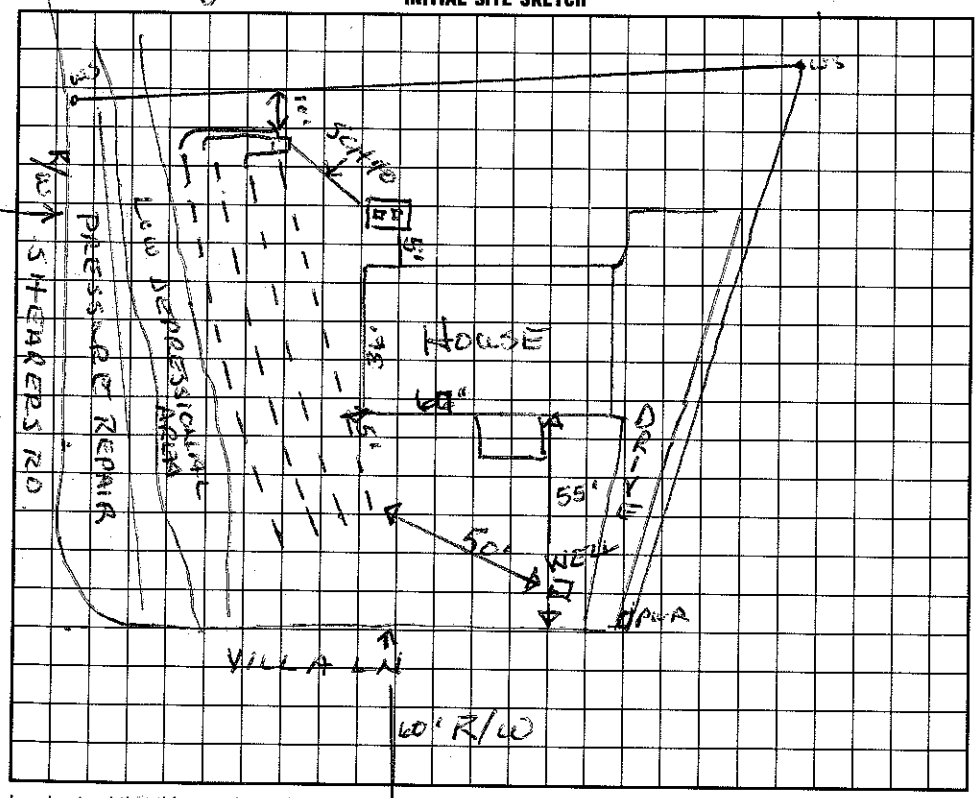

AS BUILT SKETCH

I understand that this permit can be suspended or revoked if any false information is supplied toward securing the permit/any unauthorized changes are made to the site/any unauthorized changes are made in the installation of the system. Improvement Permit is valid for 60 months from date of issuance.

Signed: X _____

Improvement Permit by: Wesley Sparks R.S. date _____

Existing System Inspection by: _____ date _____

Installed by: Barry Thompson

Certificate of Completion by: Wesley Sparks R.S. date 9/14/95

Operation Permit by: _____ date _____

HEALTH DEPT. COPY: WHITE INSPECTION COPY (FINAL): GREEN OWNER COPY (FINAL): YELLOW INSPECTION COPY (INITIAL): PINK OWNER COPY (INITIAL): GOLD