IREDELL COUNTY HEALTH DEPARTMENT

Statesville Office (704) 878-5305 Mooresville Office (704) 660-3625 PERMIT # 209499

IMPROVEMENT PERMIT / AUTHORIZATION TO CONSTRUCT / OPERATION PERMIT / EXISTING SYSTEM

PIN # 4664-49-9372

APPLICANT: CONSTANCE WHITE APPLICANT ADDRESS: 258 W. STATESVILLE AVE. MOORESVILLE

SITE ADDRESS: 105 VISTA DR., DAVIDSON PHONE: 704-663-1771 ALT. PHONE:

SITE DIRECTIONS: SHEARERS RD. TL VISTA, 1ST ON L

SUBDIVISION: BELLE GLADE SECTION: — LOT # 22 LOT AREA: .5 AC DESIGN FLOW: 360 L.T.A.R.: .3

Septic Tank 1000 (gal) STB 825 Date 6-28-16
Pump Tank (gal) PT Date
Pump Make Model Serial #
Nitrification Fields 1 # Lines 4@75' Linear Ft: 300'
Trench Width 36" Max. Trench Bottom Depth 24" Gravel Depth —

☒ New System ☐ Repair ☐ Expansion System Type: I II ☒ III IV V VI
System Description: 25% REDUCTION
Repair System Description: PANEL BLOCK
Maintenance Agreement Required: ☐ YES ☒ NO
☒ GRAVITY ☐ PRESSURE

☒ Residence No. Bedrooms 3
☐ Business No. Persons
☐ Other No. Employees
☐ Slab ☒ Crawl Space
☐ Basement w/plumbing ☐ Basement w/o plumbing

Water Supply: ☒ Private ☐ Public ☐ Community

Comments / Conditions:


8-10-16 - Recommend pumping septic tank every 3-5 years.

INITIAL SITE SKETCH



AS BUILT SKETCH

8-10-16: Rowan Septic Mid-seam 1000-gal conc. tank w/ Tuff-Tite EF-6 filter
① Tank outlett, Filter 2'4.0" OK 27' of SCH-40 PVC 3" pipe
19 Line 1 = 75' 5' 2.0" (moved laser) OK 301 L.F. 36" wide infiltrator
19 Line 2 = 78' 3' 4.5" OK Quick 4s installed
19 Line 3 = 78' 4' 6.5" OK @ 20"-24"
17 Line 4 = 70' 5' 3" OK

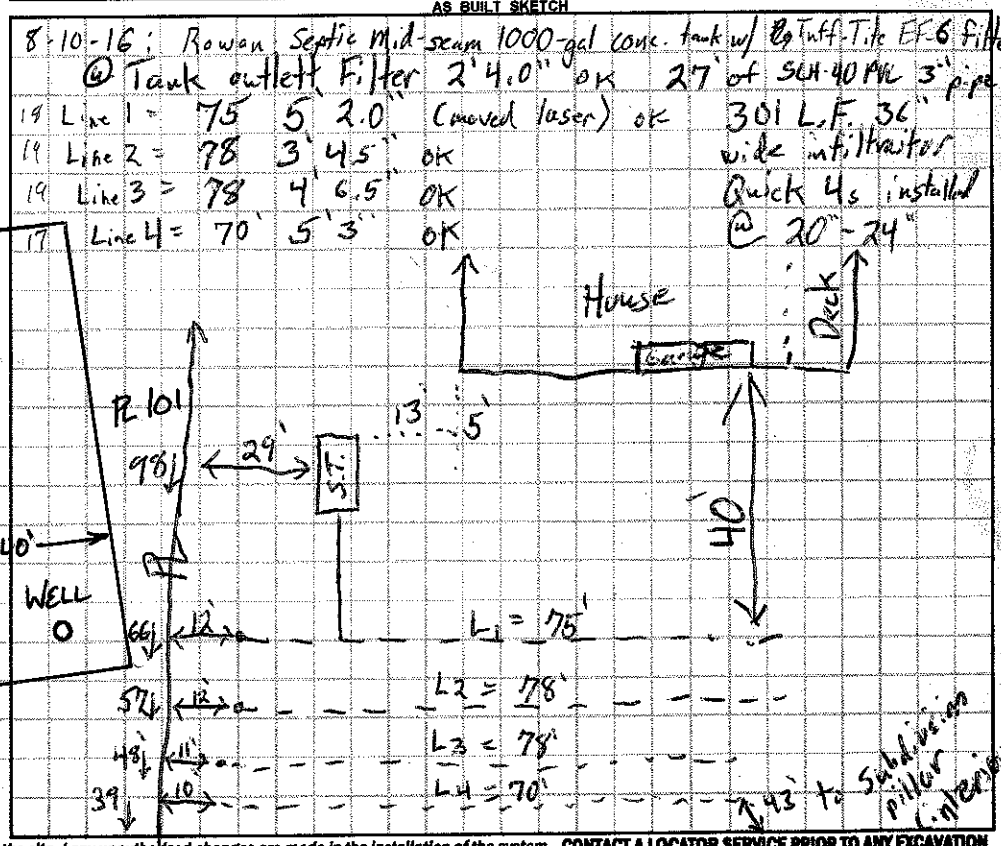

Permit can be suspended or revoked if any false information is supplied toward securing the permit / any unauthorized changes are made to the site / any unauthorized changes are made in the installation of the system. **CONTACT A LOCATOR SERVICE PRIOR TO ANY EXCAVATION**

☐ **IMPROVEMENT PERMIT** *with plat* valid without expiration. ☒ **IMPROVEMENT PERMIT** *with site plan* valid for 60 mos. ☒ **AUTHORIZATION TO CONSTRUCT** valid for period equal to IMPROVEMENT PERMIT--not to exceed 60 mo.

Owner / Applicant Signature: Constance White Date: 5/12/15 Installed by: Rowan Septic (Kevin Kirkpatrick)

IMPROVEMENT PERMIT by: APPROVED Date: MAY 11 2015 OPERATION PERMIT by: Date: 8-10-16

AUTHORIZATION TO CONSTRUCT by: APPROVED Date: MAY 11 2015 Existing System Inspected by: Date:

Health Dept. Copy - WHITE Applicant (Final Approval) - YELLOW Applicant (Conditional Approval) - PINK