# IREDELL COUNTY HEALTH DEPARTMENT

Statesville Office (704) 878-5305 ALP Mooresville Office (704) 660-3625 PERMIT # 21767

## IMPROVEMENT PERMIT / AUTHORIZATION TO CONSTRUCT / OPERATION PERMIT / EXISTING SYSTEM

PIN # 4664-49-9467.000

APPLICANT: Burt Harrington APPLICANT ADDRESS: 1603 Shearers Rd.

SITE ADDRESS: 1603 Shearers Rd. Mooresville NC 28115 PHONE: ALT. PHONE:

SITE DIRECTIONS: Shearers Rd S, Site on L Just Before Presbyterian Rd.

SUBDIVISION: — SECTION: — LOT # — LOT AREA: .430 Acres DESIGN FLOW: Ex. 360 GPD L.T.A.R.: Existing

Septic Tank Existing (gal) STB Date
Pump Tank (gal) PT Date
Pump Make Model Serial #
# Nitrification Fields Ex. # Lines Ex. 4 Linear Ft: Ex.
Trench Width Ex. Max. Trench Bottom Depth Ex. Gravel Depth Ex.


☐ New System ☐ Repair ☐ Expansion System Type: I II III IV V VI
System Description: Existing 25% Reduction - Gravity
Repair System Description:
Maintenance Agreement Required: ☐ YES ☒ NO
☒ GRAVITY ☐ PRESSURE

☒ Residence No. Bedrooms Ex 3
☐ Business No. Persons Ex 6
☐ Other No. Employees
☒ Slab ☐ Crawl Space
☐ Basement w/plumbing ☐ Basement w/o plumbing


Water Supply: ☒ Private ☐ Public ☐ Community

Comments / Conditions: Permit is For Garage Addition. System Reserved To Be Functionable @ Time Of Inspection.

INITIAL SITE SKETCH

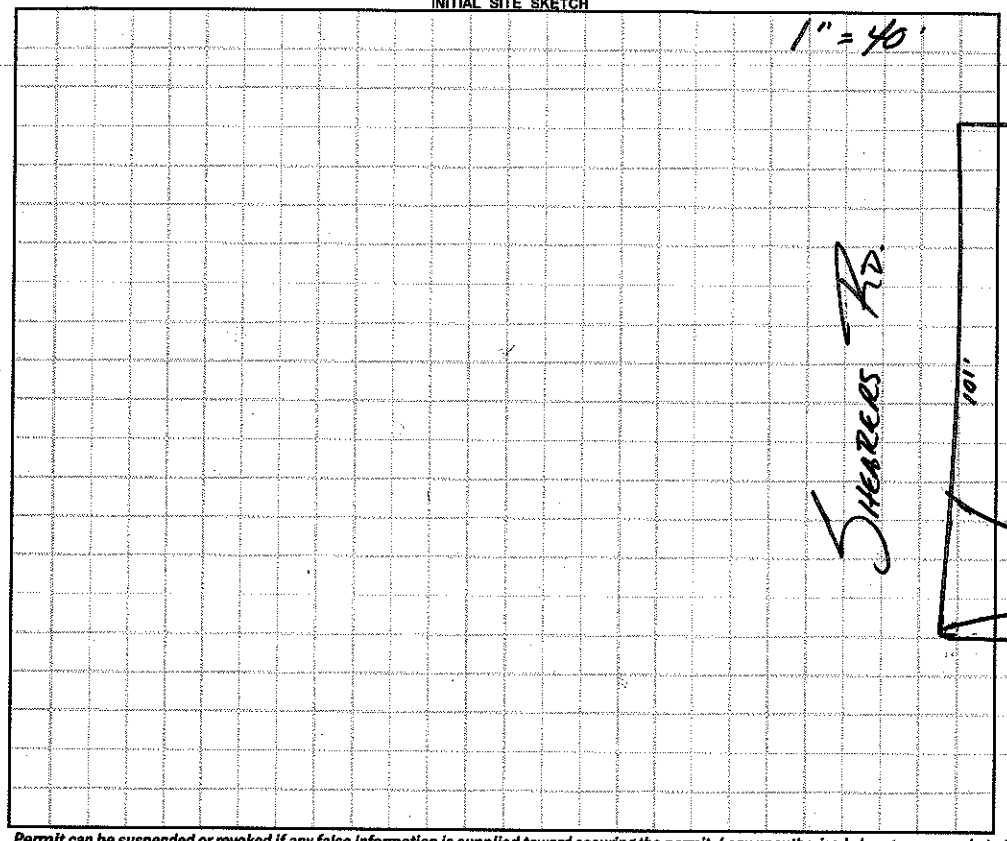


AS BUILT SKETCH

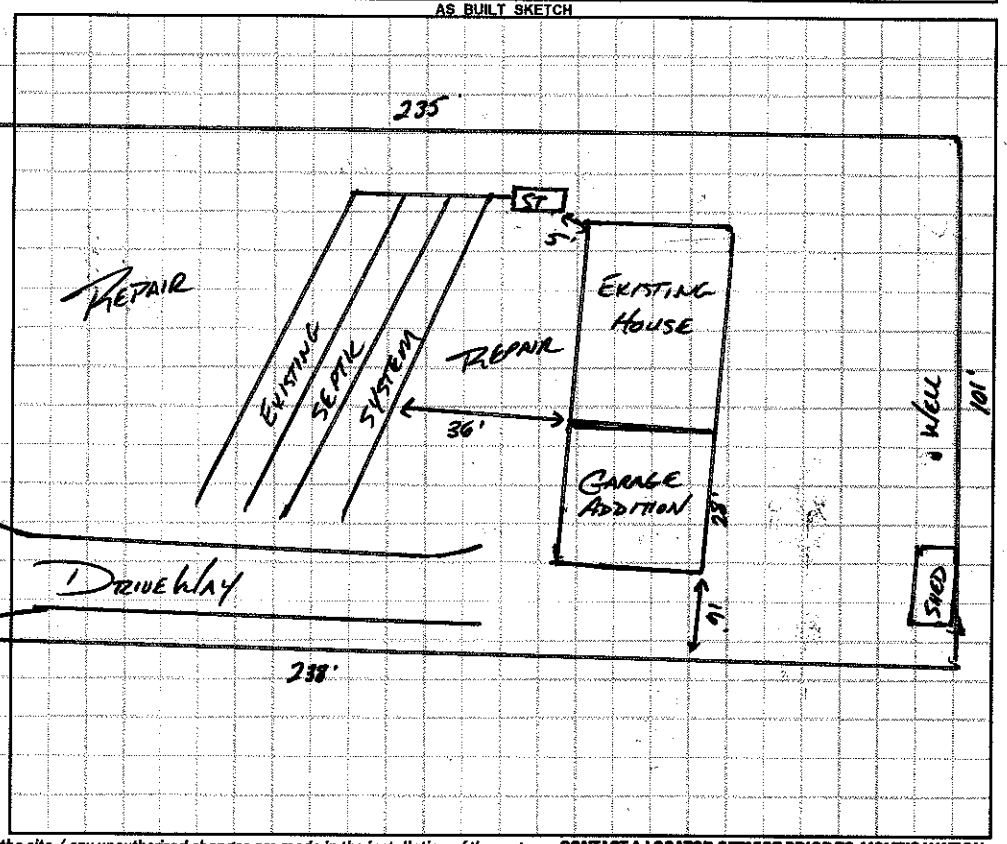


*Permit can be suspended or revoked if any false information is supplied toward securing the permit / any unauthorized changes are made to the site / any unauthorized changes are made in the installation of the system.* **CONTACT A LOCATOR SERVICE PRIOR TO ANY EXCAVATION**

☐ **IMPROVEMENT PERMIT** *with plat valid without expiration.* ☐ **IMPROVEMENT PERMIT** *with site plan valid for 60 mos.* ☐ **AUTHORIZATION TO CONSTRUCT** *valid for period equal to IMPROVEMENT PERMIT--not to exceed 60 mo.*

Owner / Applicant Signature: Burt Harrington Date: 8/4/15 Installed by:

IMPROVEMENT PERMIT by: Date: OPERATION PERMIT by: Date:

AUTHORIZATION TO CONSTRUCT by: Date: Existing System Inspected by: Date: 8/7/15

Health Dept. Copy - WHITE Applicant (Final Approval) - YELLOW Applicant (Conditional Approval) - PINK