IREDELL COUNTY HEALTH DEPARTMENT

STATESVILLE 704-878-5305 MOORESVILLE 704-664-5281

IMPROVEMENT PERMIT / AUTHORIZATION TO CONSTRUCT / OPERATION PERMIT / EXISTING SYSTEM INSPECTION

PERMIT# NONE PIN# 4664 75 5108.000 4664-54-1688 DATE 10/30/08

OWNER OR APPLICANT LEWIS PANUSKI PHONE: Business 704-995-3001 Home

ADDRESS 1827 SHEARERS RD. MOORESVILLE, NC 28117

LOCATION SHEARERS RD ON (L) AT INTERSECTION WITH GRAY RD.

SUBDIVISION NO BLOCK / SECTION LOT LOT AREA EXISTING SITE CLASS. DESIGN FLOW 300 L.T.A.R. .3

Septic Tank: 1000 Gallons; STB 794 Date 6/3/08
Pump Tank: Gallons; PT Date
Pump Make: Model Serial No.
Nitrification Field: No Fields Square Feet Linear Feet
No Lines Trench Width Max Trench Bottom Depth Gravel Depth

☐ New System ☒ Repair ☐ Expansion System Type: I (II) III IV V VI
System Description: ADDING NEW SEPTIC TANK
Repair System Description: N/A
Maintenance Agreement Required: ☐ Yes ☒ No

☐ House/Mod. Home No. Bedrooms
☐ Mobile Home No. Persons
☐ Business No. Employees
☒ Other CATERING KITCHEN

Water Supply: ☒ Individual ☐ Public ☐ Community


☒ Gravity ☐ Pressure ☐ Slab ☐ Crawl Space ☐ Basement w/plumbing ☐ Basement wo/plumbing

Comments:/Conditions:

Comments:/Conditions:

Installed as shown on AC.

INITIAL SITE SKETCH

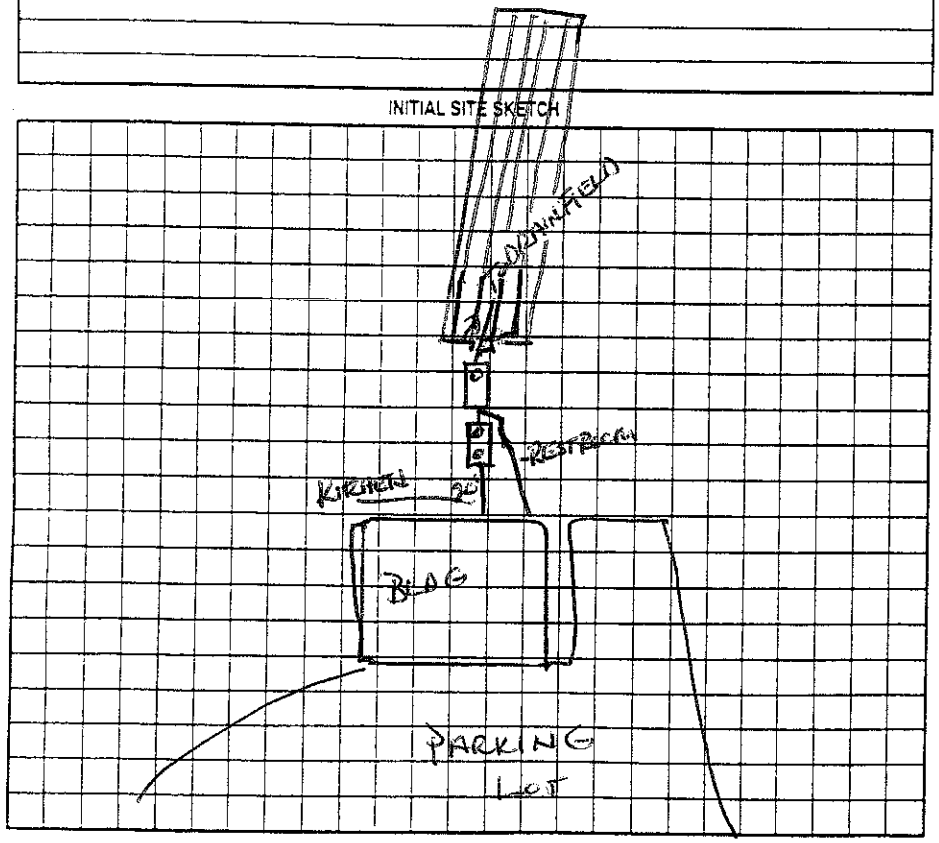

AS BUILT SKETCH

Permit can be suspended or revoked if any false information is supplied toward securing the permit/any unauthorized changes are made to the site/any unauthorized changes are made in the installation of the system. Improvement Permit with plat valid without expiration ☐ Improvement Permit with site plan valid for sixty months ☒ Authorization to Construct is valid for a period equal to that of Improvement Permit – not to exceed sixty months.

Signed: X date

Improvement Permit by: Wesley Sparks RS. date 10/30/08

Authorization to Construct by: Wesley Sparks RS. date 10/30/08

Installed by: Tackett Septic and Backhoe

Operation Permit by: Wesley Sparks RS. date 10/30/08

Existing System Inspection by: date

HEALTH DEPT. COPY: WHITE OWNER COPY (FINAL): YELLOW OWNER COPY (INITIAL): PINK