IREDELL COUNTY HEALTH DEPARTMENT

Authority to Construct

STATESVILLE 704-878-5305 MOORESVILLE 704-664-5281

IMPROVEMENT PERMIT / ~~CERTIFICATE OF COMPLETION~~ / OPERATION PERMIT / EXISTING SYSTEM INSPECTION

PROPERTY DESCRIPTION NO. Repair DATE 5/21/97 TAX MAP NO. —— Watershed: ☐ Yes ☒ No

OWNER OR CONTRACTOR Lewis Wilson PHONE: Business ____ Home 664-5418

ADDRESS Sheares Rd. Mooresville, NC. 28115

LOCATION Sheares Rd. on (L) just before stop sign for Berry Rd.

SUBDIVISION —— BLOCK / SECTION ____ LOT ____ LOT AREA ____ SITE CLASS. PS DESIGN FLOW 300 L.T.A.R. .3

Septic Tank: ____ Gallons; STB 794 Date 3/19/97

~~Pump Tank:~~ GREASE TRAP 1000 Gallons; PT ____ Date ____

Pump Make: ____ Model ____ Serial No. ____

Nitrification Field: No Fields ____ Square Feet ~~Stry Trench~~ Linear Feet ____

No Lines ____ Trench Width ____ Min. Trench Bottom Depth ____ Gravel Depth ____

☐ New System ☒ Repair System Type: ☐ I ☒ II ☐ III, IV, V, VI

System Description: Adding Grease Trap

Repair System Description: ____

Maintenance Agreement Required: ☐ Yes ☐ No

☐ House/Mod. Home No. Bedrooms ____

☐ Mobile Home No. Bathrooms ____

☒ Business No. Employees 2

☐ Other Meat Market


☐ Slab ☐ Crawl Space ☐ Basement w/plumbing ☐ Basement wo/plumbing

Water Supply: ☒ Individual ☐ Community ☐ Public


Comments:

Comments: GRAY WASH LINE HOOKED INTO SEPTIC SYSTEM

INITIAL SITE SKETCH

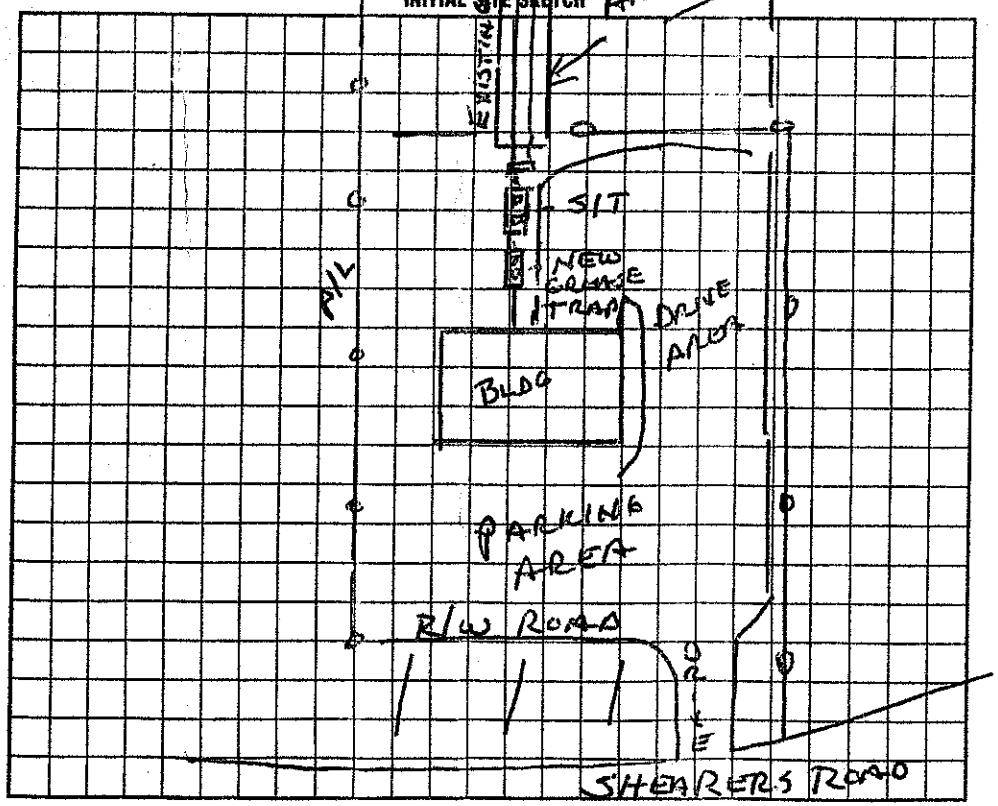

AS BUILT SKETCH

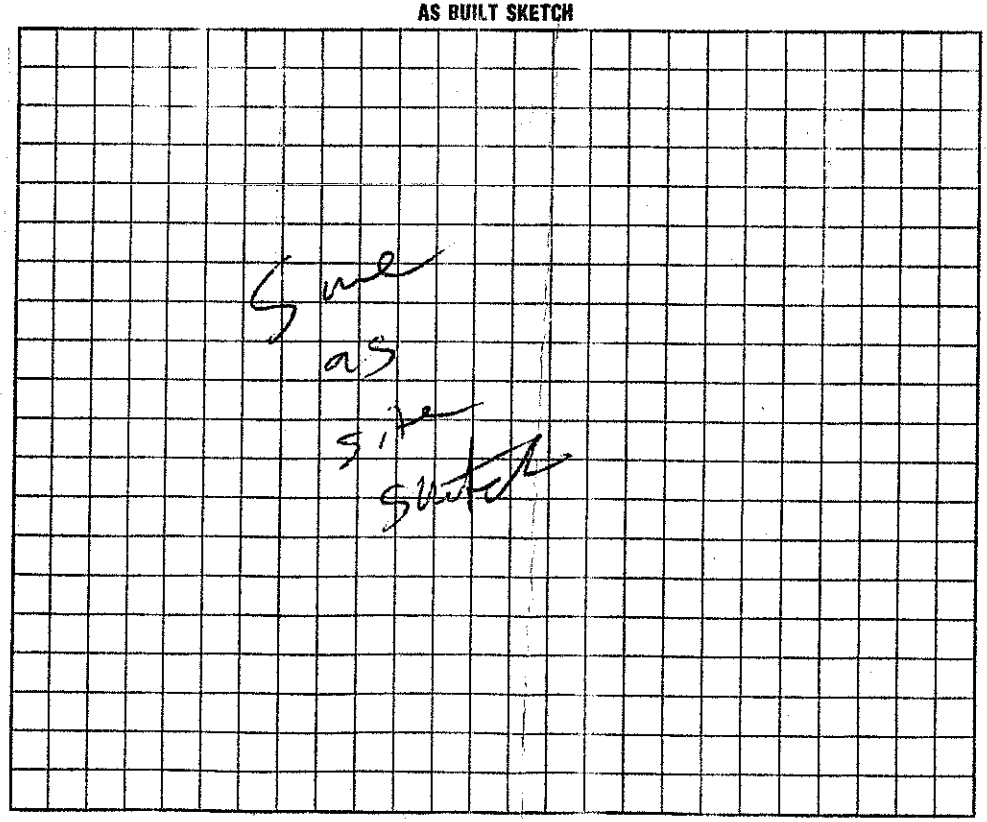

I understand that this permit can be suspended or revoked if any false information is supplied toward securing the permit/any unauthorized changes are made to the site/any unauthorized changes are made in the installation of the system. Improvement Permit is valid for 60 months from date of issuance.

Signed: ____

Improvement Permit by: Wesley Sparks RS. date 5/21/97

~~Certificate of Completion~~ New System Inspection by: Wesley Sparks RS. date 5/21/97

Installed by: FJ ERVIN

Certificate of Completion by: ____ date ____

Operation Permit by: ____ date 5/21/97