IREDELL COUNTY HEALTH DEPARTMENT

Authorization to Construct

STATESVILLE 704-878-5305 MOORESVILLE 704-664-5281

IMPROVEMENT PERMIT / ~~CERTIFICATE OF COMPLETION~~ / OPERATION PERMIT / EXISTING SYSTEM INSPECTION

PROPERTY DESCRIPTION NO. Repair DATE 5/21/97 TAX MAP NO. 4664543469 Watershed: [X] Yes [ ] No

OWNER OR CONTRACTOR Lewis Wilson PHONE: Business Home 664-5418

ADDRESS 1833 Sheares Rd. Mooresville, NC

LOCATION Sheares Rd. on (L) just past stop sign for Hampton Rd.

SUBDIVISION ___ BLOCK / SECTION ___ LOT ___ LOT AREA ___ SITE CLASS. ___ DESIGN FLOW ___ L.T.A.R. ___

Septic Tank: Existing Gallons; STB ___ Date ___

Pump Tank: ___ Gallons; PT ___ Date ___

Pump Make: ___ Model ___ Serial No. ___

Nitrification Field: No Fields 1 Square Feet 1200 Linear Feet 400

No Lines 4 Trench Width 36" Max Trench Bottom Depth 36" Gravel Depth 12"

[ ] New System [X] Repair System Type: I, (II), III, IV, V, VI

System Description: GR - CONVENTIONAL

Repair System Description: ___

Maintenance Agreement Required: [ ] Yes [ ] No

[ ] Slab [ ] Crawl Space [ ] Basement w/plumbing [ ] Basement wo/plumbing

[X] House/Mod. Home No. Bedrooms 3

[ ] Mobile Home No. Bathrooms 2

[ ] Business No. Employees ___

[ ] Other ___


Water Supply: [X] Individual [ ] Community [ ] Public

Comments:


Comments:

Installed as shown. Sentry T replaced.

INITIAL SITE SKETCH

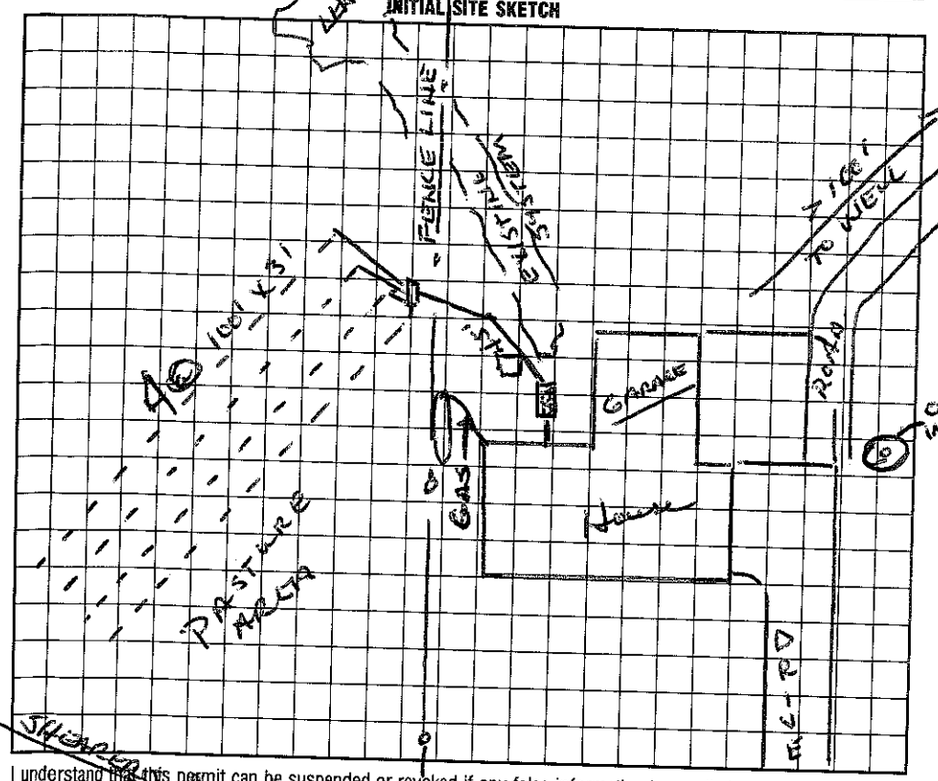

AS BUILT SKETCH

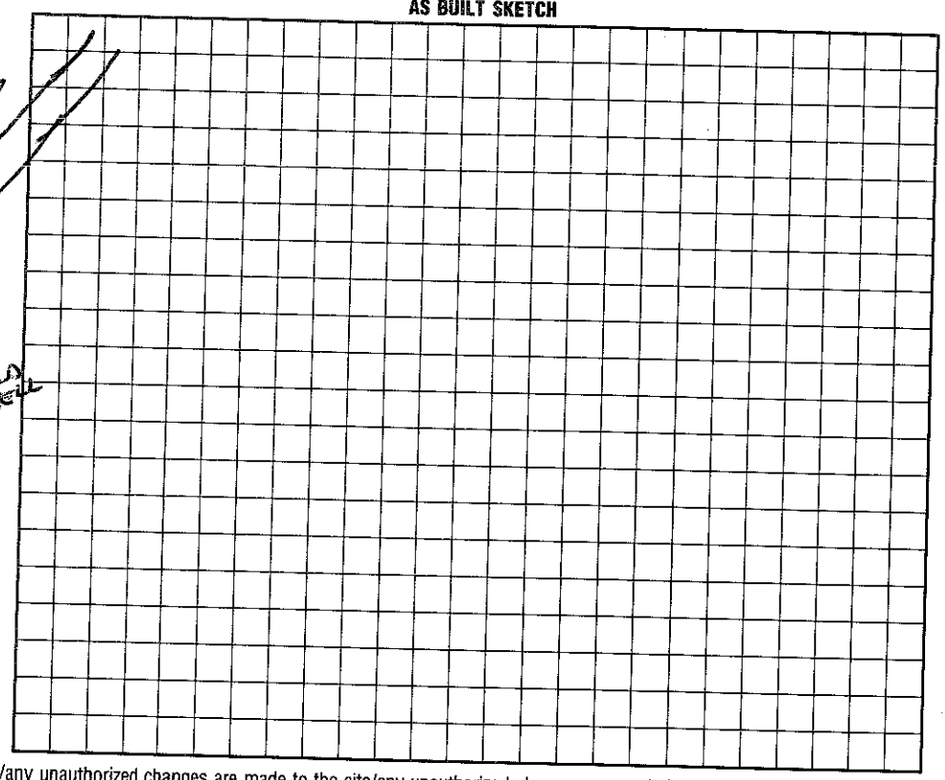

I understand that this permit can be suspended or revoked if any false information is supplied toward securing the permit/any unauthorized changes are made to the site/any unauthorized changes are made in the installation of the system. Improvement Permit is valid for 60 months from date of issuance.

Signed: ___

Improvement Permit by: Wesley Sparks R.S. date 5/21/97

Existing System Inspection by: Wesley Sparks R.S. date 5/21/97

Installed by: Julian Bowles

Certificate of Completion by: Wesley Sparks R.S. date 5/30/97

Operation Permit by: Wesley Sparks R.S. date 5/30/97

HEALTH DEPT. COPY: WHITE | INSPECTION COPY (FINAL): GREEN | OWNER COPY (FINAL): YELLOW | INSPECTION COPY (INITIAL): PINK | OWNER COPY (INITIAL): GOLD