4664551230

IREDELL COUNTY HEALTH DEPARTMENT

STATESVILLE 704-878-5305 MOORESVILLE 704-664-5281

IMPROVEMENT PERMIT / CERTIFICATE OF COMPLETION / OPERATION PERMIT / EXISTING SYSTEM INSPECTION

PROPERTY DESCRIPTION NO. lot 121 DATE 4/30/97 TAX MAP NO. 4664551230 Watershed: ☐ Yes ☒ No

OWNER OR CONTRACTOR Richard McWhorter PHONE: Business Home 892-4462

ADDRESS 1807 Shearers Rd. Statesville, NC. 28625

LOCATION Shearers Rd. ~ .314 miles on (L) past Presbyterian Rd.

SUBDIVISION BLOCK / SECTION LOT LOT AREA Existing SITE CLASS. DESIGN FLOW L.T.A.R.

Septic Tank: Gallons; STB Date

Pump Tank: Gallons; PT Date

Pump Make: Model Serial No.

Nitrification Field: No Fields 1 Square Feet 600 Linear Feet 200

No Lines 2 Trench Width 6' Max Trench Bottom Depth 36-40" Gravel Depth 14"

☐ New System ☒ Repair System Type: I, II, III, IV, V, VI

System Description: Bull Run Valve - Bed System

Repair System Description:

Maintenance Agreement Required: ☐ Yes ☒ No

☐ House/Mod. Home ☒ Mobile Home ☐ Business ☐ Other

No. Bedrooms 4 No. Bathrooms 3 No. Employees


☐ Slab ☒ Crawl Space ☐ Basement w/plumbing ☐ Basement wo/plumbing

Water Supply: ☒ Individual ☐ Community ☐ Public

Comments:

Comments:

INITIAL SITE SKETCH

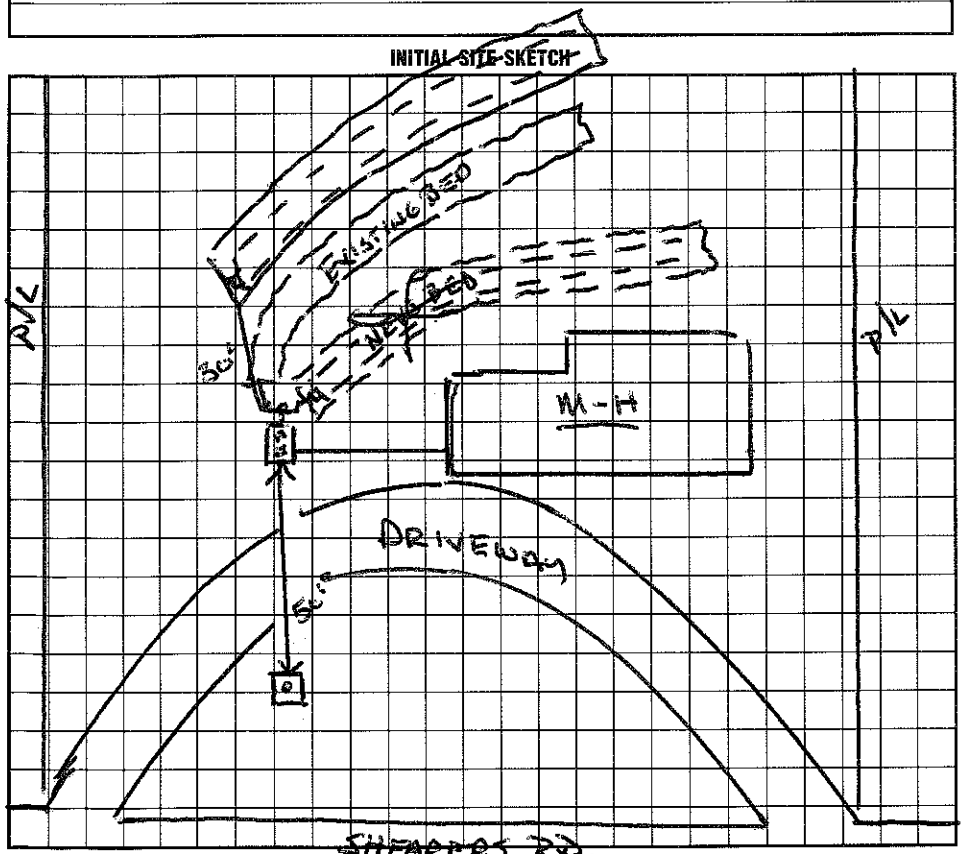

AS BUILT SKETCH

I understand that this permit can be suspended or revoked if any false information is supplied toward securing the permit/any unauthorized changes are made to the site/any unauthorized changes are made in the installation of the system. Improvement Permit is valid for 60 months from date of issuance.

Signed: Cathy McDaniel

Improvement Permit by: Wesley Sparks R.S. date 4/30/97

Existing System Inspection by: Wesley Sparks R.S. date 4/30/97

Installed by: John Sluyer

Certificate of Completion by: Wesley Sparks R.S. date 5/23/97

Operation Permit by: Wesley Sparks R.S. date 5/23/97

HEALTH DEPT. COPY: WHITE INSPECTION COPY (FINAL): GREEN OWNER COPY (FINAL): YELLOW INSPECTION COPY (INITIAL): PINK OWNER COPY (INITIAL): GOLD