IREDELL COUNTY HEALTH DEPARTMENT

STATESVILLE [illegible]578-5305 MOORESVILLE 704-664-5281

IMPROVEMENT PERMIT / AUTHORIZATION TO CONSTRUCT / OPERATION PERMIT / EXISTING SYSTEM INSPECTION

PERMIT# 123292 PIN# ~~4664070278.041~~ 4664-56-1783 ✓ DATE 2-12-07

OWNER OR APPLICANT Edwards Construction PHONE: Business _____ Home _____

Site ADDRESS 124 Elizabeth Brook Dr. - Davidson

LOCATION Sheaters Rd, Lt Anniston way TR Logan TR Elizabeth at end on Rt

SUBDIVISION Anniston BLOCK / SECTION 1 LOT 41/41A LOT AREA 1.01 Ac SITE CLASS. PS DESIGN FLOW 480 L.T.A.R. .25

Septic Tank: 1000 Gallons; STB 7969 Date 10-10-06

Pump Tank: 1000 Gallons; PT 1233 Date 1-3-07

Pump Make: Goulds Model WE1512HH Serial No. _____

Nitrification Field: No Fields 1 Square Feet 640 Linear Feet 320

No Lines 5 Trench Width 24" Max Trench Bottom Depth 36"

☒ New System ☐ Repair ☐ Expansion System Type: I II III IV V VI

System Description: LP Pixel Blk

Repair System Description: Same

Maintenance Agreement Required: ☒ Yes ☐ No

☒ House/Mod. Home No. Bedrooms 4

☐ Mobile Home No. Persons ____

☐ Business No. Employees ____

☐ Other _____


Water Supply: ☒ Individual ☐ Public ☐ Community

Gravel Depth NA ☐ Gravity ☒ Pressure ☐ Slab ☒ Crawl Space ☐ Basement w/plumbing ☐ Basement wo/plumbing

Comments:/Conditions:

Comments:/Conditions: 5/32" hole drilled 2/16/07 Checked lines & pressure - MD Electric alarm

INITIAL SITE SKETCH 100% Repair

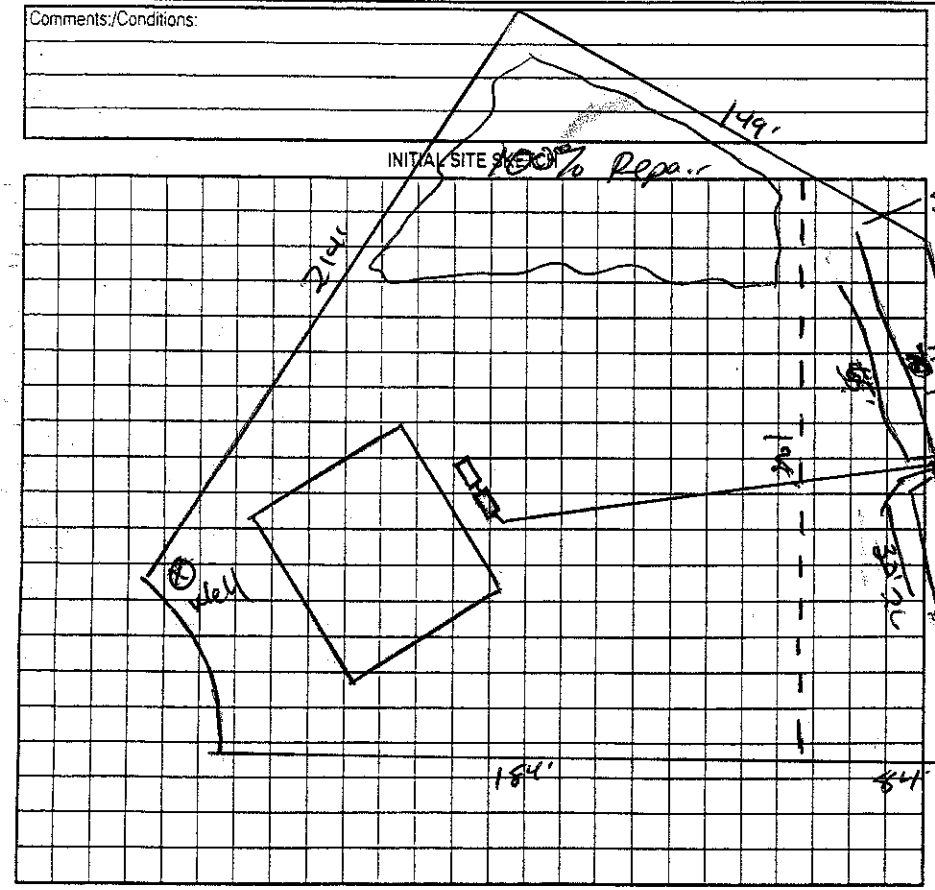

AS BUILT SKETCH

Permit can be suspended or revoked if any false information is supplied toward securing the permit/any unauthorized changes are made to the site/any unauthorized changes are made in the installation of the system. Improvement Permit with plat valid without expiration. ☐ Improvement Permit with site plan valid for sixty months ☒ Authorization to Construct is valid for a period equal to that of Improvement Permit – not to exceed sixty months.

Signed: Andrew Allen Ressley date 2/13/07 Installed by: Marty Tucker

Improvement Permit by: Josh E Alph date 12-13-07 Operation Permit by: Marty Tucker date 2/16/07

Authorization to Construct by: Josh E Alph date 12-13-07 Existing System Inspection by: _____ date _____

HEALTH DEPT. COPY: WHITE OWNER COPY (FINAL): YELLOW OWNER COPY (INITIAL): PINK